

County: Lyon Fraction: NE, SE, NE, SE Sec. 5 T. 21 S R. 11 E

CORRECTION(S) to WATER WELL COMPLETION RECORD Form WWC-5 (to rectify lacking or incorrect information)

Owner: Matthew Brinkman

If location corrected, was listed as:

Section-Township-Range: _____

Fraction (¼ calls): SE

Location changed to:

NE, SE, NE, SE

Other changes: Initial statements: Trimble GPS unit used but no horizontal datum (HD) reported.

Insufficient info provided on well and plugging procedure.

Changed to: HD WGS84. Blank casing - rock, top 5 ft removed, plugging materials/intervals were:

18-5 ft - bleach, rock and gravel; 5-4 ft bentonite chips; 4-0 ft compacted clay & soil.

Comments: _____

Verification method: Contacted Bloom Excavating for missing information and confirmation of location based on lat/long coordinates using KDHE Section/Township/Range Finder.

Initials: PKC Date: 2/13/2021

Submitted by: ☐ Kansas Geological Survey, Data Resources Library, 1930 Constant Ave., Lawrence, KS 66047-3724

☒ Kansas Dept. of Health & Environment, Bureau of Water, 1000 SW Jackson, Suite 420, Topeka, KS 66612-1367

WATER WELL PLUGGING RECORD

Form WWC-5P

KSA 82a-1212

ID NO.

1 LOCATION OF WATER WELL: County: Lyon	Fraction SE ¼ ¼ ¼ ¼	Section Number 5	Township Number T 21 S	Range Number 11 <input checked="" type="checkbox"/> E <input type="checkbox"/> W
---	------------------------	---------------------	---------------------------	---

Street/Rural Address of Well Location; if unknown, distance & direction from nearest town or intersection: If at owner's address, check here ☒ 637 Road J
Olpe, KS 66865


Global Positioning Systems (GPS) information:

Latitude: 38.250128 N (in decimal degrees)
Longitude: 96.211949 W (in decimal degrees)
Elevation: 1268
Horizontal Datum: ☐ WGS84, ☐ NAD83, ☐ NAD27
Collection Method:

2 WATER WELL OWNER: Matthew Brinkman
RR#, St. Address, Box #: PO Box 122
City, State ZIP Code: Olpe, KS 66865

☒ GPS unit (Make/Model: Trimble)
☐ Digital Map/Photo, ☒ Topographic Map, ☐ Land Survey
Est. Accuracy: ☒ < 3 m, ☐ 3-5 m, ☐ 5-15 m, ☐ > 15 m

3 MARK WELL'S LOCATION WITH AN "X" IN SECTION BOX:

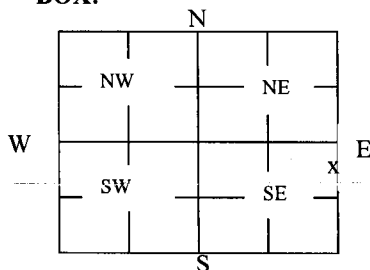

4 DEPTH OF WELL 18 ft.

WELL'S STATIC WATER LEVEL 10 ft

WELL WAS USED AS:

☒ Domestic ☐ Public Water Supply ☐ Dewatering
☐ Irrigation ☐ Oil Field Water Supply ☐ Monitoring
☐ Feedlot ☐ Domestic (Lawn & Garden) ☐ Injection Well
☐ Industrial ☐ Air Conditioning ☐ Other

Was a chemical/bacteriological sample submitted to Department? Yes ☐ No ☒

5 TYPE OF BLANK CASING USED:

☐ Steel ☐ RMP (SR) ☐ Wrought ☐ Fiberglass ☒ Other (Specify below)
☐ PVC ☐ ABS ☐ Asbestos-Cement ☐ Concrete Tile ☐ No Casing

Blank casing diameter _____ in. Was casing pulled? Yes ☐ No ☒ If yes, how much _____
Casing height above or below land surface NA in.

6 GROUT PLUG MATERIAL: ☐ Neat cement ☐ Cement grout ☒ Bentonite ☐ Other

Grout Plug Intervals: From _____ ft. to _____ ft., From _____ ft. to _____ ft., From _____ ft. to _____ ft.

What is the nearest source of possible contamination:

☐ Septic tank ☐ Seepage pit ☐ Fuel storage ☐ Other (specify below)
☐ Sewer lines ☐ Pit privy ☐ Fertilizer storage
☐ Watertight sewer lines ☐ Sewage lagoon ☐ Insecticide storage
☐ Lateral lines ☐ Feedyard ☐ Abandoned water well Direction from well? _____
☐ Cess pool ☐ Livestock pens ☐ Oil well/Gas well How many feet? _____

FROM	TO	PLUGGING MATERIALS	FROM	TO	PLUGGING MATERIALS

7 CONTRACTOR'S OR LANDOWNER'S CERTIFICATION: This water well was plugged under my jurisdiction and was completed on (mo/day/year) 12-20-2020 and this record is true to the best of my knowledge and belief. Kansas Water Well Contractor's License No. _____ This Water Well Record was completed on (mo/day/year) 12-20-2020 under the business name of Bloom Excavating by (signature) Jerry Bloom

Send one white copy to Kansas Department of Health & Environment, Geology Section, 1000 SW Jackson Street, Ste. 420, Topeka, KS 66612-1367. Send one copy to WATER WELL OWNER and retain one for your records.
Visit us at <http://www.kdheks.gov/waterwell/index.html> Telephone 785-296-5524.

KSA82a-1212

Revised 1/20/2015