


WATER WELL RECORD Form WWC-5 KSA 82a-1212

1 LOCATION OF WATER WELL: County: Stafford Fraction: N/C₄ E¹/₂ 1/4 NW 1/4 Section Number: 10 Township Number: T 21 S Range Number: R 13 XE/W

Distance and direction from nearest town or city street address of well if located within city?
4 1/4 north, 2 1/2 east seward, Ks.

2 WATER WELL OWNER: Hugo Damm
 RR#, St. Address, Box #: Rt. 2- Box 56 Board of Agriculture, Division of Water Resources
 City, State, ZIP Code: Great Bend, Ks. 67530 Application Number:

3 LOCATE WELL'S LOCATION WITH AN "X" IN SECTION BOX:

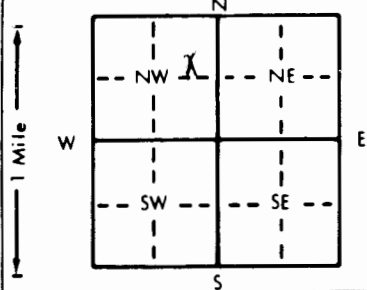

4 DEPTH OF COMPLETED WELL: 7.4 ft. ELEVATION:
 Depth(s) Groundwater Encountered 1. ft. 2. ft. 3. ft.
 WELL'S STATIC WATER LEVEL: 18 ft. below land surface measured on mo/day/yr 12-11-97
 Pump test data: Well water was ft. after hours pumping gpm
 Est. Yield: na gpm: Well water was ft. after hours pumping gpm
 Bore Hole Diameter: 7 in. to 7.4 ft., and in. to ft.
 WELL WATER TO BE USED AS:
 5 Public water supply 8 Air conditioning 11 Injection well
 1 Domestic 3 Feedlot 6 Oil field water supply 9 Dewatering 12 Other (Specify below)
 2 Irrigation 4 Industrial 7 Lawn and garden only 10 Monitoring well test hole
 Was a chemical/bacteriological sample submitted to Department? Yes x No If yes, mo/day/yr sample was submitted
 Water Well Disinfected? Yes No x

5 TYPE OF BLANK CASING USED:
 1 Steel 3 RMP (SR) 6 Asbestos-Cement 9 Other (specify below) Welded
 2 PVC 4 ABS 7 Fiberglass Threaded
 Blank casing diameter: 3 in. to 5.8 ft., Dia. 3 in. to 7.3 to 6.3 ft., Dia. in. to ft.
 Casing height above land surface: 2 in., weight Sch. 80 lbs./ft. Wall thickness or gauge No.
 TYPE OF SCREEN OR PERFORATION MATERIAL:
 1 Steel 3 Stainless steel 5 Fiberglass 8 RMP (SR) 11 Other (specify)
 2 Brass 4 Galvanized steel 6 Concrete tile 9 ABS 12 None used (open hole)
 SCREEN OR PERFORATION OPENINGS ARE:
 1 Continuous slot 3 Mill slot 5 Gauzed wrapped 8 Saw cut 11 None (open hole)
 2 Louvered shutter 4 Key punched 6 Wire wrapped 9 Drilled holes
 7 Torch cut 10 Other (specify)
 SCREEN-PERFORATED INTERVALS: From 63 ft. to 58 ft., From ft. to ft.
 GRAVEL PACK INTERVALS: From 7.4 ft. to 51 ft., From ft. to ft.

6 GROUT MATERIAL: 1 Neat cement 2 Cement grout 3 Bentonite 4 Other hole plug 51 to 49
 Grout Intervals: From 51 ft. to 14 ft., From ft. to ft., From 14 to ft. 0 ft.
 What is the nearest source of possible contamination:
 1 Septic tank 4 Lateral lines 7 Pit privy 10 Livestock pens 14 Abandoned water well
 2 Sewer lines 5 Cess pool 8 Sewage lagoon 11 Fuel storage 15 Oil well/Gas well
 3 Watertight sewer lines 6 Seepage pit 9 Feedyard 12 Fertilizer storage 16 Other (specify below)
 13 Insecticide storage
 Direction from well? north How many feet? 600

FROM	TO	LITHOLOGIC LOG	FROM	TO	PLUGGING INTERVALS
0	6	Sandy top soil			
6	15	Gray clay			
15	22	Brown & white clay			
22	33	Rusty Brown & white clay little rock			
33	35 1/2	Sand and gravel			
35 1/2	36	Brown clay			
36	51	Sand and gravel medium clean			
51	52	Brown clay			
52	62	Fine sand loose some clay in it.			
62	71	Sandy brown clay & fine sand			
71	72	White caliche			
72	74	Sand rock			

7 CONTRACTOR'S OR LANDOWNER'S CERTIFICATION: This water well was (1) constructed, (2) reconstructed, or (3) plugged under my jurisdiction and was completed on (mo/day/year) 12-11-97 and this record is true to the best of my knowledge and belief. Kansas Water Well Contractor's License No. 134 This Water Well Record was completed on (mo/day/yr) 12-12-97 under the business name of Rosenkrantz-bemis by (signature) Freda Jackson

INSTRUCTIONS: Use typewriter or ball point pen. PLEASE PRESS FIRMLY and PRINT clearly. Please fill in blanks, underline or circle the correct answers. Send top three copies to Kansas Department of Health and Environment, Bureau of Water, Topeka, Kansas 66620-0001. Telephone: 913-296-5545. Send one to WATER WELL OWNER and retain one for your records.

OFFICE USE ONLY T R E W SEC 1/4 1/4 1/4