

County: Coffey Fraction NW NW Sec. 15 T 21 S R 14 E

CORRECTION(S) TO WATER WELL COMPLETION RECORD (WWC-5)

(to rectify lacking or incorrect information)

Owner: Andrew Seth Trupin

Location was listed as:

Location changed to:

Section-Township-Range: 15-21-14

15-21S-14E

Fraction (1/4 1/4 1/4): None Given

NW NW

Other changes: Initial statements: _____

Changed to: _____

Comments: _____

Verification method: Legal description, position shown on plat map, Coffey County online parcel search, and mapping tool & aerial photos on KGS website initials: AT date: 2/23/2017


Submitted by: Kansas Geological Survey, Data Resources Library, 1930 Constant Ave., Lawrence, KS 660473726
to: Kansas Dept of Health & Environment, Bureau of Water, 1000 SW Jackson, Suite 420, Topeka, KS 66612-1367.

1 LOCATION OF WATER WELL: Fraction $\frac{1}{4}$ $\frac{1}{4}$ $\frac{1}{4}$ Section Number 15 Township Number 21 Range Number 14 E/W

County: Coffey

Distance and direction from nearest town or city street address of well if located within city? n/a

2 WATER WELL OWNER: Andrew Seth Trupin **Global Positioning Systems** (decimal degrees, min. of 4 digits)
 RR#, St. Address, Box #: 720 Lake Ave. Latitude: _____
 City, State ZIP Code: N. Delray Beach, FL 33483 Longitude: _____
 Elevation: _____
 Datum: _____
 Data Collection Method: _____

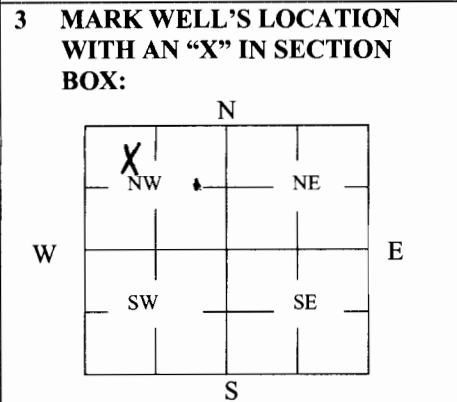

4 DEPTH OF WELL 28 ft.
 WELL'S STATIC WATER LEVEL 18 ft.
 WELL WAS USED AS:
 Domestic 5 Public Water Supply 9 Dewatering
 2 Irrigation 6 Oil Field Water Supply 10 Monitoring
 3 Feedlot 7 Domestic (Lawn & Garden) 11 Injection Well
 4 Industrial 8 Air Conditioning 12 Other _____
 Was a chemical/bacteriological sample submitted to Department? Yes _____ No _____

5 TYPE OF BLANK CASING USED:
 1 Steel 3 RMP (SR) 5 Wrought 7 Fiberglass 9 Other (Specify below) Rock
 2 PVC 4 ABS 6 Asbestos-Cement 8 Concrete Tile

Blank casing diameter _____ in. Was casing pulled? Yes _____ No X If yes, how much _____
 Casing height above or below land surface _____ in.

6 GROUT PLUG MATERIAL: 1 Neat cement 2 Cement grout Bentonite 4 Other 3/4" limestone rock

Grout Plug Intervals: From 28 ft. to 18 ft., From 18 ft. to 10 ft., From 10 to 5 ft.
of rock & clay remaining 5ft was clay & bentonite

What is the nearest source of possible contamination:
 1 Septic tank 6 Seepage pit 11 Fuel Storage 16 Other (specify below) no sources of contamination
 2 Sewer lines 7 Pit privy 12 Fertilizer storage
 3 Watertight sewer lines 8 Sewage lagoon 13 Insecticide storage
 4 Lateral lines 9 Feedyard 14 Abandoned water well Direction from well? n/a
 5 Cess pool 10 Livestock pens 15 Oil well/Gas well How many feet? n/a

FROM	TO	PLUGGING MATERIALS	FROM	TO	PLUGGING MATERIALS
<u>28'</u>	<u>18'</u>	<u>limestone rock 3/4"</u>			
<u>18'</u>	<u>10'</u>	<u>clay</u>			
<u>10'</u>	<u>5'</u>	<u>clay</u>			
<u>5'</u>	<u>surface</u>	<u>bentonite</u>			
	<u>cover 1/4"</u>	<u>clay</u>			

7 CONTRACTOR'S OR LANDOWNER'S CERTIFICATION: This water well was plugged under my jurisdiction and was completed on (mo/day/year) 11-11-16 and this record is true to the best of my knowledge and belief. Kansas Water Well Contractor's License No. _____ This Water Well Record was completed on (mo/day/year) 11-15-16 under the business name of _____ by (signature) Don A. Clair (Skillman Perist)

INSTRUCTIONS: Use typewriter or ballpoint pen. Please press firmly and print clearly. Please fill in blanks, underline or circle the correct answers. Send top three copies to Kansas Department of Health and Environment, Bureau of Water, Geology Section, 1000 SW Jackson St., Ste. 420, Topeka, Kansas 66612-1367. Telephone: 785/296-5522. Send one to Water Well Owner and retain one for your records. Visit us at <http://www.kdheks.gov/geo/waterwells>.