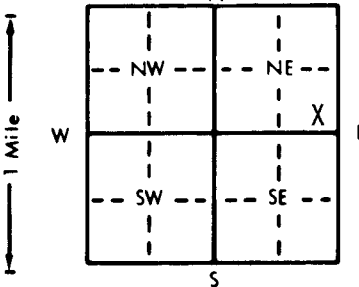


1 LOCATION OF WATER WELL: County: Coffey Fraction SE 1/4 SE 1/4 NE 1/4 Section Number 1 Township Number T 21 S Range Number R 15 **EN**

Distance and direction from nearest town or city street address of well if located within city?  
5 mi north, 2 mi east, 1.5 mi south of Burlington

2 WATER WELL OWNER: KG&E, KCP and L, KEPCo  
RR#, St. Address, Box # : P.O. Box 411 Board of Agriculture, Division of Water Resources  
City, State, ZIP Code : Burlington, KS 66839 Application Number:

3 LOCATE WELL'S LOCATION WITH AN "X" IN SECTION BOX:  4 DEPTH OF COMPLETED WELL: 30 ft. ELEVATION:   
Depth(s) Groundwater Encountered 1. ft. 2. ft. 3. ft.   
WELL'S STATIC WATER LEVEL 14 ft. below land surface measured on mo/day/yr 12-20-91  
Pump test data: Well water was NA ft. after hours pumping gpm  
Est. Yield gpm: Well water was NA ft. after hours pumping gpm  
Bore Hole Diameter NA in. to ft., and in. to ft.  
WELL WATER ~~XXXX~~ USED AS: 5 Public water supply 8 Air conditioning 11 Injection well  
1 Domestic WAS 3 Feedlot 6 Oil field water supply 9 Dewatering 12 Other (Specify below)  
2 Irrigation 4 Industrial 7 Lawn and garden only 10 Monitoring well  
Was a chemical/bacteriological sample submitted to Department? Yes No X; If yes, mo/day/yr sample was submitted  
Water Well Disinfected? Yes X No

5 TYPE OF BLANK CASING USED: 5 Wrought iron 8 Concrete tile CASING JOINTS: Glued Clamped  
1 Steel 3 RMP (SR) 6 Asbestos-Cement 9 Other (specify below) Welded  
2 PVC 4 ABS 7 Fiberglass Native Stone Rock Threaded  
Blank casing diameter 4.8 in. to ft., Dia in. to ft., Dia in. to ft.  
Casing height above land surface 6 feet below X weight lbs./ft. Wall thickness or gauge No.  
TYPE OF SCREEN OR PERFORATION MATERIAL: 7 PVC 10 Asbestos-cement  
1 Steel 3 Stainless steel 5 Fiberglass 8 RMP (SR) 11 Other (specify) N/A  
2 Brass 4 Galvanized steel 6 Concrete tile 9 ABS 12 None used (open hole)  
SCREEN OR PERFORATION OPENINGS ARE: 5 Gauzed wrapped 8 Saw cut 11 None (open hole)  
1 Continuous slot 3 Mill slot 6 Wire wrapped 9 Drilled holes  
2 Louvered shutter 4 Key punched 7 Torch cut 10 Other (specify) N/A  
SCREEN-PERFORATED INTERVALS: From ft. to ft., From ft. to ft.  
GRAVEL PACK INTERVALS: From ft. to ft., From ft. to ft.

6 GROUT MATERIAL: 1 Neat cement 2 Cement grout 3 Bentonite 4 Other  
Grout Intervals: From 7 ft. to 5 ft., From ft. to ft., From ft. to ft.  
What is the nearest source of possible contamination: 10 Livestock pens 14 Abandoned water well  
1 Septic tank 4 Lateral lines 7 Pit privy 11 Fuel storage 15 Oil well/Gas well  
2 Sewer lines 5 Cess pool 8 Sewage lagoon 12 Fertilizer storage 16 Other (specify below)  
3 Watertight sewer lines 6 Seepage pit 9 Feedyard 13 Insecticide storage Cropland  
Direction from well? South How many feet? 150 feet

FROM	TO	LITHOLOGIC LOG	FROM	TO	PLUGGING INTERVALS
30 ft	15 ft	Crushed gravel, disinfected			
15 ft	7 ft	Compacted clay			
7 ft	5 ft	Cement Grout (2 cubic yards)			
5 ft	Surface	Compacted clay / top soil			

7 CONTRACTOR'S OR LANDOWNER'S CERTIFICATION: This water well was (1) constructed, (2) reconstructed, or (3) plugged under my jurisdiction and was completed on (mo/day/year) 12-20-91 and this record is true to the best of my knowledge and belief. Kansas Water Well Contractor's License No. NA This Water Well Record was completed on (mo/day/yr) 1-12-92 under the business name of NA by (signature)