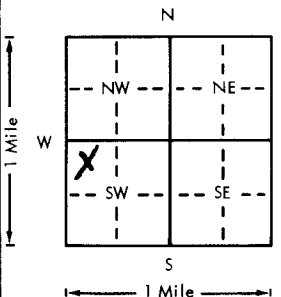
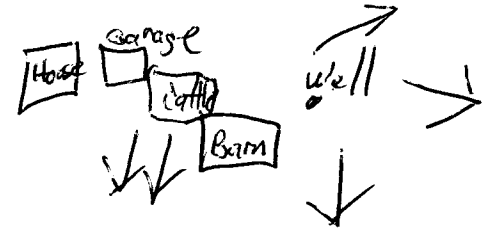


USE TYPEWRITER OR BALL POINT PEN-PRESS FIRMLY, PRINT CLEARLY.

WATER WELL RECORD
KSA 82a-1201-1215

Kansas Department of Health and Environment-Division of Environment
(Water well Contractors)
Topeka, Kansas 66620

1. Location of well:	County Coffey	Fraction NW 1/4 NW 1/4 SW 1/4	Section number 11	Township number T 21 S R 15 E/W	Range number																																				
X Distance and direction from nearest town or city: Street address of well location if in city:			3. Owner of well: James Hess R.R. or street: RR 2 City, state, zip code: Burlington, Ks																																						
4. Locate with "X" in section below: 		Sketch map: 		6. Bore hole dia. 8 in. Completion date 3-23-77 Well depth 60 ft.																																					
5. Type and color of material		From To		7. <input checked="" type="checkbox"/> Cable tool <input type="checkbox"/> Rotary <input type="checkbox"/> Driven <input type="checkbox"/> Dug <input type="checkbox"/> Hollow rod <input type="checkbox"/> Jetted <input type="checkbox"/> Bored <input type="checkbox"/> Reverse rotary																																					
<table border="1" style="width:100%; border-collapse: collapse;"> <tr><td>Topsoil</td><td>Black</td><td>0</td><td>4</td></tr> <tr><td>Sandy Clay</td><td>Tan</td><td>4</td><td>15</td></tr> <tr><td>Rock - Soft</td><td>Tan</td><td>15</td><td>18</td></tr> <tr><td>Shale</td><td>Grey</td><td>18</td><td>25</td></tr> <tr><td>Rock - Hard</td><td>Light Grey</td><td>25</td><td>30</td></tr> <tr><td>Shale</td><td>Grey</td><td>30</td><td>37</td></tr> <tr><td>Rock - Hard</td><td>Light Grey</td><td>37</td><td>45</td></tr> <tr><td>Shale</td><td>Grey</td><td>45</td><td>56</td></tr> <tr><td>Rock Hard</td><td>White</td><td>56</td><td>60</td></tr> </table>		Topsoil	Black	0	4	Sandy Clay	Tan	4	15	Rock - Soft	Tan	15	18	Shale	Grey	18	25	Rock - Hard	Light Grey	25	30	Shale	Grey	30	37	Rock - Hard	Light Grey	37	45	Shale	Grey	45	56	Rock Hard	White	56	60	8. Use: <input type="checkbox"/> Domestic <input type="checkbox"/> Public supply <input type="checkbox"/> Industry <input type="checkbox"/> Irrigation <input type="checkbox"/> Air conditioning <input checked="" type="checkbox"/> Stock <input type="checkbox"/> Lawn <input type="checkbox"/> Oil field water <input type="checkbox"/> Other		9. Casing: Material _____ Height: Above or below Threaded _____ Welded _____ Surface _____ in. RMP _____ PVC _____ Weight _____ lbs./ft. Dia. _____ in. to _____ ft. depth Wall Thickness: inches or Dia. _____ in. to _____ ft. depth gage No. _____	
This was a dry well. It was plugged according to state code laws. A cement plug was put between 20-10ft and filled to top with soil.		10. Screen: Manufacturer's name _____ Type _____ Dia. _____ Slot/gouze _____ length _____ Set between _____ ft. and _____ ft. _____ ft. and _____ ft. Gravel pack? _____ Size range of material _____		11. Static water level: _____ mo./day/yr. _____ ft. below land surface Date _____																																					
(Use a second sheet if needed)		12. Pumping level below land surfaces: _____ ft. after _____ hrs. pumping _____ g.p.m. _____ ft. after _____ hrs. pumping _____ g.p.m. Estimated maximum yield _____ g.p.m.		13. Water sample submitted: _____ mo./day/yr. Yes <input checked="" type="checkbox"/> No <input type="checkbox"/> Date _____																																					
18. Elevation:		19. Remarks:		14. Well head completion: <input type="checkbox"/> Pitless adapter <input checked="" type="checkbox"/> _____ Inches above grade																																					
Topography: <input type="checkbox"/> Hill <input type="checkbox"/> Slope <input checked="" type="checkbox"/> Upland <input type="checkbox"/> Valley		20. Water well contractor's certification: This well was drilled under my jurisdiction and this report is true to the best of my knowledge and belief. Bledsoe Drilling Co. 152 Business name _____ License No. _____ Address Burlington, Ks Signed Wayne P. Bledsoe Date 3-30-77 Authorized representative		15. Well grouted? With: <input type="checkbox"/> Neat cement <input type="checkbox"/> Bentonite <input type="checkbox"/> Concrete Depth: From _____ ft. to _____ ft.																																					

Forward the white, blue and pink copies to the Department of Health and Environment

Form WWC-5