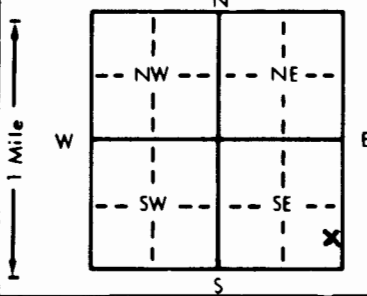


1 LOCATION OF WATER WELL: County: COFFEY Fraction: SE 1/4 SE 1/4 SE 1/4 Section Number: 17 Township Number: T 21 S Range Number: R 15 E

Distance and direction from nearest town or city street address of well if located within city?
1 M N CD RD FASIO + 2 W OF HWY 75 - NW of BURLINGTON


2 WATER WELL OWNER: STAN BIRKBECK
 RR#, St. Address, Box #: ROUTE 3 Board of Agriculture, Division of Water Resources
 City, State, ZIP Code: BURLINGTON KS 66839 Application Number:

3 LOCATE WELL'S LOCATION WITH AN "X" IN SECTION BOX:

 4 DEPTH OF COMPLETED WELL: 28 ft. ELEVATION: -
 Depth(s) Groundwater Encountered 1. 19 ft. 2. - ft. 3. - ft.
 WELL'S STATIC WATER LEVEL: 6 ft. below land surface measured on mo/day/yr 06-29-89
 * Pump test data: Well water was - ft. after - hours pumping - gpm
 Est. Yield *100 gpm: Well water was - ft. after - hours pumping - gpm
 Bore Hole Diameter: 12 1/2 in. to 28 ft., and - in. to - ft.
 WELL WATER TO BE USED AS:
 5 Public water supply 8 Air conditioning 11 Injection well
 1 Domestic 3 Feedlot 6 Oil field water supply 9 Dewatering 12 Other (Specify below)
 2 Irrigation 4 Industrial 7 Lawn and garden only 10 Monitoring well -
 Was a chemical/bacteriological sample submitted to Department? Yes - No X; If yes, mo/day/yr sample was submitted -
 Water Well Disinfected? Yes X No -

5 TYPE OF BLANK CASING USED:
 1 Steel 3 RMP (SR) 6 Asbestos-Cement 9 Other (specify below) Welded -
 2 PVC 4 ABS 7 Fiberglass Threaded -
 Blank casing diameter: 5 in. to 28 ft., Dia - in. to - ft., Dia - in. to - ft.
 Casing height above land surface: 24 in., weight 160 RS 1.73 lbs./ft. Wall thickness or gauge No. -
 TYPE OF SCREEN OR PERFORATION MATERIAL:
 1 Steel 3 Stainless steel 5 Fiberglass 8 RMP (SR) 10 Asbestos-cement
 2 Brass 4 Galvanized steel 6 Concrete tile 9 ABS 11 Other (specify) -
 12 None used (open hole)
 SCREEN OR PERFORATION OPENINGS ARE:
 1 Continuous slot 3 Mill slot 4 ROW 5 Gauzed wrapped 8 Saw cut 11 None (open hole)
 2 Louvered shutter 4 Key punched 7 Torch cut 9 Drilled holes 10 Other (specify) -
 SCREEN-PERFORATED INTERVALS: From 18 ft. to 28 ft., From - ft. to - ft., From - ft. to - ft.
 GRAVEL PACK INTERVALS: From 6 ft. to 28 ft., From - ft. to - ft., From - ft. to - ft.

6 GROUT MATERIAL: 1 Neat cement 2 Cement grout 3 Bentonite 4 Other -
 Grout Intervals: From 4 ft. to 6 ft., From - ft. to - ft., From - ft. to - ft.
 What is the nearest source of possible contamination: NA
 1 Septic tank 4 Lateral lines 7 Pit privy 10 Livestock pens 14 Abandoned water well
 2 Sewer lines 5 Cess pool 8 Sewage lagoon 11 Fuel storage 15 Oil well/Gas well
 3 Watertight sewer lines 6 Seepage pit 9 Feedyard 12 Fertilizer storage 16 Other (specify below) -
 13 Insecticide storage
 Direction from well? - How many feet? -

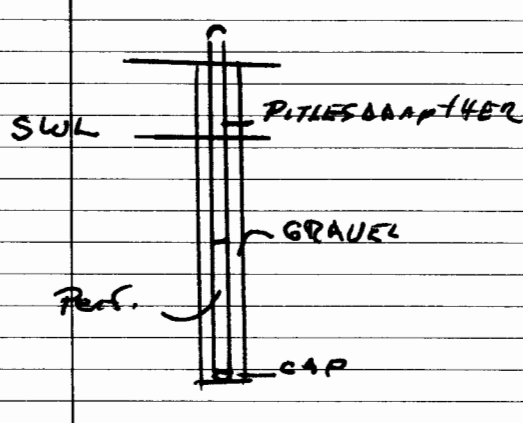FROM	TO	LITHOLOGIC LOG	FROM	TO	PLUGGING INTERVALS
<u>0</u>	<u>4</u>	<u>DK GREY SILT</u>			
<u>4</u>	<u>18</u>	<u>SILT-CLAY</u>			
<u>18</u>	<u>20</u>	<u>SDY SILT</u>			
<u>20</u>	<u>28</u>	<u>GRAVEL</u>			



7 CONTRACTOR'S OR LANDOWNER'S CERTIFICATION: This water well was (1) constructed, (2) reconstructed, or (3) plugged under my jurisdiction and was completed on (mo/day/year) 06-29-89 and this record is true to the best of my knowledge and belief. Kansas Water Well Contractor's License No. 479 This Water Well Record was completed on (mo/day/yr) 06-29-89 under the business name of EBBERTS DRILLING by (signature) Gregg Ebberts

OFFICE USE ONLY

T

R

EW

SEC.

1/4

1/4

1/4