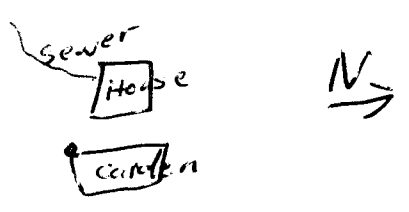


USE TYPEWRITER OR BALL POINT PEN-PRESS FIRMLY, PRINT CLEARLY.

WATER WELL RECORD
KSA 82a-1201-1215

Kansas Department of Health and Environment-Division of Environment (Water well Contractors) Topeka, Kansas 66620

1. Location of well: County Coffey		Fraction NE 1/4 NE 1/4 SE 1/4		Section number 22		Township number T 21 S		Range number R 15 EW			
2. Distance and direction from nearest town or city: Lots 14, 20 B1 #3 Wilson, Adcl. Burlington, Ks				3. Owner of well: George Sheets R.R. or street: 577 Martindale City, state, zip code: Burlington, Ks 66839							
4. Locate with "X" in section below: N 1 Mile W E S 1 Mile				Sketch map: 		6. Bore hole dia. 3 in. Completion date 3-25-77 Well depth 30 ft.					
5. Type and color of material				From		To		7. <input checked="" type="checkbox"/> Cable tool <input type="checkbox"/> Rotary <input type="checkbox"/> Driven <input type="checkbox"/> Dug <input type="checkbox"/> Hollow rod <input type="checkbox"/> Jetted <input type="checkbox"/> Bored <input type="checkbox"/> Reverse rotary			
				8. Use: <input type="checkbox"/> Domestic <input type="checkbox"/> Public supply <input type="checkbox"/> Industry <input type="checkbox"/> Irrigation <input type="checkbox"/> Air conditioning <input type="checkbox"/> Stock <input checked="" type="checkbox"/> Lawn <input type="checkbox"/> Oil field water <input type="checkbox"/> Other							
Top Soil Black 0 2								9. Casing: Material PTTS Height: Above or below Threaded <input type="checkbox"/> Welded <input checked="" type="checkbox"/> Surface 36 in. RMP <input type="checkbox"/> PVC <input checked="" type="checkbox"/> Weight _____ lbs./ft. Dia. 5 in. to 30 ft. depth Wall Thickness: inches or Dia. _____ in. to _____ ft. depth gage No. 258			
Sandy Clay Tan 2 19								10. Screen: Manufacturer's name _____ Shop perforated Type P19 Dia. 5 1/2" Slot/gauze 3/32" Length 6 ft Set between 19 ft. and 25 ft. _____ ft. and _____ ft. Gravel pack? yes Size range of material 3/8			
Sand - Gravel Brown 19 25								11. Static water level: _____ mo./day/yr. 16 ft. below land surface Date 3-25-77			
Shale Grey 25 30								12. Pumping level below land surfaces: _____ ft. after _____ hrs. pumping _____ g.p.m. _____ ft. after _____ hrs. pumping _____ g.p.m. Estimated maximum yield 25 gpm g.p.m.			
								13. Water sample submitted: _____ mo./day/yr. <input type="checkbox"/> Yes <input checked="" type="checkbox"/> No Date _____			
								14. Well head completion: owner to finish <input type="checkbox"/> Pitless adapter 36 in Inches above grade			
								15. Well grouted? yes With: <input checked="" type="checkbox"/> Neat cement <input type="checkbox"/> Bentonite <input type="checkbox"/> Concrete Depth: From 15 ft. to 5 ft.			
								16. Nearest source of possible contamination: Sanitary ft. 40 ft Direction West Type sewer Well disinfected upon completion? <input checked="" type="checkbox"/> Yes <input type="checkbox"/> No			
								17. Pump: <input checked="" type="checkbox"/> Not installed Manufacturer's name _____ Model number _____ HP _____ Volts _____ Length of drop pipe _____ ft. capacity _____ g.p.m. Type: <input type="checkbox"/> Submersible <input type="checkbox"/> Turbine <input type="checkbox"/> Jet <input type="checkbox"/> Reciprocating <input type="checkbox"/> Centrifugal <input type="checkbox"/> Other			
								20. Water well contractor's certification: This well was drilled under my jurisdiction and this report is true to the best of my knowledge and belief. Bledsoe Drilling Co. 152 Business name _____ License No. _____ Address Strong, C.F. Ks Signed Hayden P. Bledsoe Date 3-27-77 Authorized representative			
18. Elevation:		19. Remarks:									
Topography: <input type="checkbox"/> Hill <input type="checkbox"/> Slope <input checked="" type="checkbox"/> Upland <input type="checkbox"/> Valley											

T 21
R 15
W
S
Sec 22
NE
1/4
NE
1/4
SE

Forward the white, blue and pink copies to the Department of Health and Environment

Form WWC-5