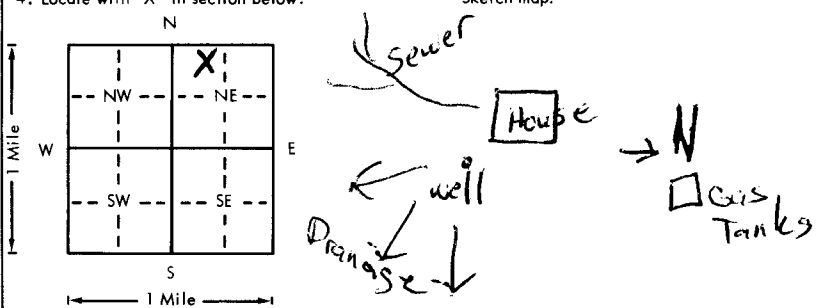


USE TYPEWRITER OR BALL  
POINT PEN-PRESS FIRMLY,  
PRINT CLEARLY.

WATER WELL RECORD  
KSA 82a-1201-1215

Kansas Department of Health and  
Environment-Division of Environment  
(Water well Contractors)  
Topeka, Kansas 66620

1. Location of well: County <u>Coffey</u>		Fraction <u>NE 1/4 NW 1/4 NE 1/4</u>	Section number <u>35</u>	Township number <u>T 21 S</u>	Range number <u>R 15 W</u>
2. Distance and direction from nearest town or city: <u>1/2 mi. E, 1 mi. S</u>		3. Owner of well: <u>William Williams</u>			
Street address of well location if in city: <u>Burlington, Ks</u>		R.R. or street: <u>RR1</u>			
		City, state, zip code: <u>Burlington, Ks 66839</u>			
4. Locate with "X" in section below: 		6. Bore hole dia. <u>8</u> in. Completion date <u>4-9-77</u> Well depth <u>35</u> ft.			
		7. <input checked="" type="checkbox"/> Cable tool <input type="checkbox"/> Rotary <input type="checkbox"/> Driven <input type="checkbox"/> Dug <input type="checkbox"/> Hollow rod <input type="checkbox"/> Jetted <input type="checkbox"/> Bored <input type="checkbox"/> Reverse rotary			
		8. Use: <input checked="" type="checkbox"/> Domestic <input type="checkbox"/> Public supply <input type="checkbox"/> Industry <input type="checkbox"/> Irrigation <input type="checkbox"/> Air conditioning <input type="checkbox"/> Stock <input type="checkbox"/> Lawn <input type="checkbox"/> Oil field water <input type="checkbox"/> Other			
		9. Casing: Material <u>PTES</u> Height: <u>Above</u> or below Threaded <input type="checkbox"/> Welded <input checked="" type="checkbox"/> Surface <u>24</u> in. RMP <input type="checkbox"/> PVC <input checked="" type="checkbox"/> Weight <u>35</u> lbs./ft. Dia. <u>5</u> in. to <u>35</u> ft. depth Wall Thickness: <u>inches</u> Dia. <u>in.</u> to <u>ft.</u> depth gage No. <u>258</u>			
5. Type and color of material		From	To	10. Screen: Manufacturer's name <u>Shop perforated</u> Type <u>3/8" PC</u> Dia. <u>5"</u> Slot/gauze <u>3/32"</u> Length <u>8 1/2'</u> Set between <u>25</u> ft. and <u>3.3</u> ft. Gravel pack? <u>yes</u> Size range of material <u>3/8"</u>	
<u>Top Soil</u>		<u>Black</u>	<u>0</u>	<u>4</u>	11. Static water level: <u>15</u> ft. below land surface Date <u>4-9-77</u>
<u>Clay &amp; Sand</u>		<u>Tan</u>	<u>4</u>	<u>18</u>	12. Pumping level below land surfaces: ____ ft. after ____ hrs. pumping ____ g.p.m. ____ ft. after ____ hrs. pumping ____ g.p.m. Estimated maximum yield <u>25 gpm</u> g.p.m.
<u>Gravel</u>		<u>Brown</u>	<u>18</u>	<u>30</u>	13. Water sample submitted: ____ Yes <input checked="" type="checkbox"/> No Date ____
<u>Shale</u>		<u>Grey</u>	<u>30</u>	<u>35</u>	14. Well head completion: <u>well seal</u> ____ Pitless adapter <u>24</u> inches above grade
					15. Well grouted? <u>yes</u> With: <input checked="" type="checkbox"/> Neat cement <input type="checkbox"/> Bentonite <input type="checkbox"/> Concrete Depth: From <u>15</u> ft. to <u>5</u> ft.
					16. Nearest source of possible contamination: <u>95</u> ft. Direction <u>North</u> Type <u>gas tank</u> Well disinfected upon completion? <input checked="" type="checkbox"/> Yes <input type="checkbox"/> No
					17. Pump: <input checked="" type="checkbox"/> Not installed Manufacturer's name ____ Model number ____ HP ____ Volts ____ Length of drop pipe ____ ft. capacity ____ g.p.m. Type: ____ Submersible ____ Turbine ____ Jet ____ Reciprocating ____ Centrifugal ____ Other
					20. Water well contractor's certification: This well was drilled under my jurisdiction and this report is true to the best of my knowledge and belief. <u>Blades Drilling Co.</u> <u>15-2</u> Business name License No. Address <u>Strong City, Mo</u> Signed <u>Wayne P. Blades</u> Date <u>4-11-77</u> Authorized representative
18. Elevation:		19. Remarks:			
Topography: <input type="checkbox"/> Hill <input checked="" type="checkbox"/> Slope <input checked="" type="checkbox"/> Upland <input checked="" type="checkbox"/> Valley					

Forward the white, blue and pink copies to the Department of Health and Environment

Form WWC-5