


WATER WELL PLUGGING RECORD Form WWC-5P KSA 82a-1212 ID NO.

1 LOCATION OF WATER WELL: County: COFFEY	Fraction NW ¼ SW ¼ NE ¼	Section Number 7	Township Number 21 S	Range Number 16 E E/W
--	----------------------------	---------------------	-------------------------	--------------------------

Distance and direction from nearest town or city street address of well if located within city?
WOLF CREEK NUCLEAR OPERATING CORPORATION
 1550 OXEN LANE NE, BURLINGTON, KS 66839

2 WATER WELL OWNER: WOLF CREEK NUCLEAR OP.CORP. RR#, St. Address, Box #: 1550 OXEN LANE NE City, State ZIP Code: BURLINGTON, KS 66839	Global Positioning Systems (decimal degrees, min. of 4 digits) Latitude: 38.237158 Longitude: -95.690719 Elevation: _____ Datum: WGS 84 Data Collection Method: DIGITAL MAP/GOOGLE EARTH
--	--

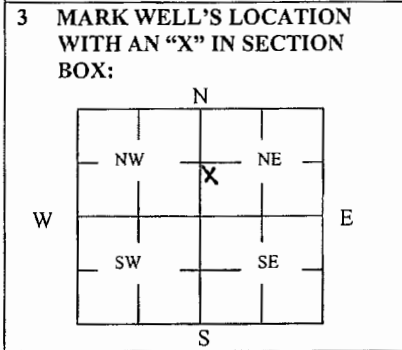

4 DEPTH OF WELL 48.5 ft.

WELL'S STATIC WATER LEVEL _____ ft

WELL WAS USED AS: MONITORING WELL: MW-4B

1 Domestic	5 Public Water Supply	9 Dewatering
2 Irrigation	6 Oil Field Water Supply	10 Monitoring
3 Feedlot	7 Domestic (Lawn & Garden)	11 Injection Well
4 Industrial	8 Air Conditioning	12 Other _____

Was a chemical/bacteriological sample submitted to Department? Yes ___ No ___

5 TYPE OF BLANK CASING USED:

1 Steel	3 RMP (SR)	5 Wrought	7 Fiberglass	9 Other (Specify below)
2 PVC	4 ABS	6 Asbestos-Cement	8 Concrete Tile	_____

Blank casing diameter 2 1/2 in. Was casing pulled? Yes No _____ If yes, how much ALL
 Casing height above or below land surface _____ in.

6 GROUT PLUG MATERIAL: 1 Neat cement 2 Cement grout 3 Bentonite 4 Other _____

Grout Plug Intervals: From 0 ft. to 48.5 ft., From _____ ft. to _____ ft., From _____ to _____ ft.

What is the nearest source of possible contamination:

1 Septic tank	6 Seepage pit	11 Fuel Storage	16 Other (specify below) <u>COOLING LAKE / NUCLEAR REACTOR</u>
2 Sewer lines	7 Pit privy	12 Fertilizer storage	
3 Watertight sewer lines	8 Sewage lagoon	13 Insecticide storage	
4 Lateral lines	9 Feedyard	14 Abandoned water well	Direction from well? <u>SOUTH</u>
5 Cess pool	10 Livestock pens	15 Oil well/Gas well	How many feet? <u>LESS THAN 600 FT.</u>

FROM	TO	PLUGGING MATERIALS	FROM	TO	PLUGGING MATERIALS
0	48.5'	High Solids Bentonite Grout			
					(REDI JOB # 122172-AR)

7 CONTRACTOR'S OR LANDOWNER'S CERTIFICATION: This water well was plugged under my jurisdiction and was completed on (mo/day/year) 10/29/12 and this record is true to the best of my knowledge and belief. Kansas Water Well Contractor's License No. 788. This Water Well Record was completed on (mo/day/year) 01/03/13 under the business name of ROBERTS ENV. DRILLING, INC. by (signature) *Charles Roberts*

INSTRUCTIONS: Use typewriter or ballpoint pen. Please press firmly and print clearly. Please fill in blanks, underline or circle the correct answers. Send top three copies to Kansas Department of Health and Environment, Bureau of Water, Geology Section, 1000 SW Jackson St., Ste. 420, Topeka, Kansas 66612-1367. Telephone: 785/296-5522. Send one to Water Well Owner and retain one for your records. Visit us at <http://www.kdheks.gov/geo/waterwells>.

WHITE