


1 LOCATION OF WATER WELL: County: COFFEY Fraction: NW 1/4 NE 1/4 NW 1/4 Section Number: 8 Township Number: T 21 S Range Number: R 17 EW

Distance and direction from nearest town or city street address of well if located within city?
10 miles East and 2 North of Burlington Ks.

2 WATER WELL OWNER: STEVE LOWE
 RR#, St. Address, Box #: R.R. 2 BOX 100A
 City, State, ZIP Code: Westphalia, KS, 66093
 Board of Agriculture, Division of Water Resources
 Application Number:

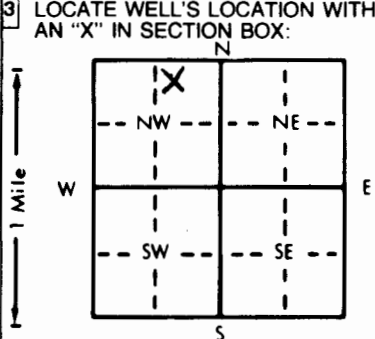

4 DEPTH OF COMPLETED WELL: 90 ft. ELEVATION:
 Depth(s) Groundwater Encountered: 1 21-65 ft. 2. ft. 3. ft.
 WELL'S STATIC WATER LEVEL: 32 ft. below land surface measured on mo/day/yr: 8-1-94
 Pump test data: Well water was ft. after hours pumping gpm
 Est. Yield: 15 gpm; Well water was ft. after hours pumping gpm
 Bore Hole Diameter: 8 3/4 in. to 20 ft., and 6 3/4 in. to 90 ft.
 WELL WATER TO BE USED AS:
 1 Domestic 3 Feedlot 6 Oil field water supply 9 Dewatering 12 Other (Specify below)
 2 Irrigation 4 Industrial 7 Lawn and garden only 10 Monitoring well
 Was a chemical/bacteriological sample submitted to Department? Yes. No ; If yes, mo/day/yr sample was submitted
 Water Well Disinfected? Yes No

5 TYPE OF BLANK CASING USED:
 1 Steel 3 RMP (SR) 6 Asbestos-Cement 9 Other (specify below) CASING JOINTS: Glued Clamped
 2 PVC 4 ABS 7 Fiberglass Welded
 Blank casing diameter: 5 in. to 80 ft., Dia. in. to ft., Dia. in. to ft.
 Casing height above land surface: 30 in., weight lbs./ft. Wall thickness or gauge No. 200#
 TYPE OF SCREEN OR PERFORATION MATERIAL:
 1 Steel 3 Stainless steel 5 Fiberglass 7 PVC 10 Asbestos-cement
 2 Brass 4 Galvanized steel 6 Concrete tile 9 ABS 11 Other (specify)
 12 None used (open hole)
 SCREEN OR PERFORATION OPENINGS ARE:
 1 Continuous slot 3 Mill slot 5 Gauzed wrapped 8 Saw cut 11 None (open hole)
 2 Louvered shutter 4 Key punched 6 Wire wrapped 9 Drilled holes
 7 Torch cut 10 Other (specify)
 SCREEN-PERFORATED INTERVALS: From 80 ft. to 90 ft., From ft. to ft.
 GRAVEL PACK INTERVALS: From ft. to ft., From ft. to ft.

6 GROUT MATERIAL: 1 Neat cement 2 Cement grout 3 Bentonite 4 Other
 Grout Intervals: From 20 ft. to 0 ft., From ft. to ft., From ft. to ft.
 What is the nearest source of possible contamination:
 1 Septic tank 4 Lateral lines 7 Pit privy 10 Livestock pens 14 Abandoned water well
 2 Sewer lines 5 Cess pool 8 Sewage lagoon 11 Fuel storage 15 Oil well/Gas well
 3 Watertight sewer lines 6 Seepage pit 9 Feedyard 12 Fertilizer storage 16 Other (specify below)
 13 Insecticide storage
 Direction from well? ESE How many feet? 200

FROM	TO	LITHOLOGIC LOG	FROM	TO	PLUGGING INTERVALS
0	6	Soil			
9	15	Brown SAND			
15	21	Clay			
21	39	SAND			
38	45	SAND + shale			
45	52	SAND Light Gray			
52	60	Shale			
60	65	SAND			
65	88	Shale			
88	90	Limestone			

7 CONTRACTOR'S OR LANDOWNER'S CERTIFICATION: This water well was (1) constructed, (2) reconstructed, or (3) plugged under my jurisdiction and was completed on (mo/day/year) 8-1-94 and this record is true to the best of my knowledge and belief. Kansas Water Well Contractor's License No. 561 This Water Well Record was completed on (mo/day/yr) 8-3-94 under the business name of EVANS Energy Dev. Inc. by (signature) [Signature]

INSTRUCTIONS: Use typewriter or ball point pen. PLEASE PRESS FIRMLY and PRINT clearly. Please fill in blanks, underline or circle the correct answers. Send top three copies to Kansas Department of Health and Environment, Bureau of Water, Topeka, Kansas 66620-0001. Telephone: 913-296-5545. Send one to WATER WELL OWNER and retain one for your records.

OFFICE USE ONLY
T
R
EW
SEC.
1/4
1/4
1/4