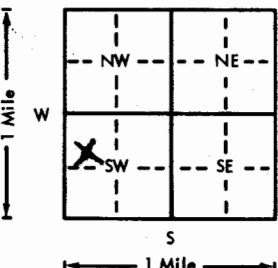
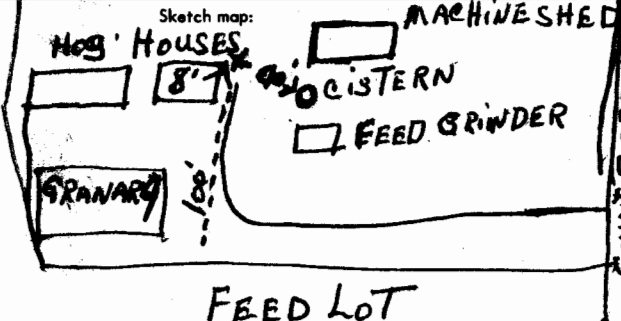


USE TYPEWRITER OR BALL
POINT PEN-PRESS FIRMLY,
PRINT CLEARLY.

PAGE I

WATER WELL RECORD
KSA 82a-1201-1215

Kansas Department of Health and
Environment-Division of Environment
(Water well Contractors)
Topeka, Kansas 66620

1. Location of well:		County ANDERSON	Fraction SW 1/4 SW 1/4	Section number 6	Township number T 21 S	Range number R 18 E
2. Distance and direction from nearest town or city: Street address of well location if in city:		2 1/2 MILES NORTH MT. IDA KANSAS		3. Owner of well: R.R. or street: City, state, zip code:		
4. Locate with "X" in section below:		Sketch map:		6. Bore hole dia. 6 1/2 in. Completion date 2/17/77 Well depth 395 ft.		
				7. <input checked="" type="checkbox"/> Cable tool <input type="checkbox"/> Rotary <input type="checkbox"/> Driven <input type="checkbox"/> Dug <input type="checkbox"/> Hollow rod <input type="checkbox"/> Jetted <input type="checkbox"/> Bored <input type="checkbox"/> Reverse rotary		
5. Type and color of material		From		To		8. Use: <input type="checkbox"/> Domestic <input type="checkbox"/> Public supply <input type="checkbox"/> Industry <input type="checkbox"/> Irrigation <input type="checkbox"/> Air conditioning <input checked="" type="checkbox"/> Stock <input type="checkbox"/> Lawn <input type="checkbox"/> Oil field water <input type="checkbox"/> Other
SOIL + JOINT CLAY		15		0		9. Casing: Material STEEL Height: Above or below Threaded USED Surface 16 in. RMP USED Weight 19 lbs./ft. Dia. 6 1/2 in. to 19 ft. depth Wall Thickness: inches or Dia. 6 1/2 in. to 19 ft. depth gage No. 19
WHITE LIME LAYERS		3		15		10. Screen: Manufacturer's name Type NONE Dia. Slot/gauze Length Set between 7 ft. and 25 ft. Gravel pack? NO Size range of material NONE
BLUE LIME		7		18		11. Static water level: 37 ft. below land surface Date 2/15/77 mo./day/yr.
GRAY SHALE		2		25		12. Pumping level below land surfaces: ft. after 1/2 hrs. pumping 1/2 g.p.m. ft. after 1 hrs. pumping 1/2 g.p.m. Estimated maximum yield 1/2 g.p.m.
BLUE LIME		18		27		13. Water sample submitted: NO Date Yes No Date
BLACK SHALE		1		45		14. Well head completion: 16 inches above grade Pitless adapter
TRACE OF RED SHALE		46		78		15. Well grouted? X Not installed With: <input type="checkbox"/> Neat cement <input type="checkbox"/> Bentonite <input checked="" type="checkbox"/> Concrete Depth: From 18 ft. to 3 ft.
GRAY SHALE		32		46		16. Nearest source of possible contamination: ft. 8 Direction NORTH Type Hog House Well disinfected upon completion? <input checked="" type="checkbox"/> Yes <input type="checkbox"/> No
BLUE LIME		20		78		17. Pump: X Not installed Manufacturer's name Model number HP Volts Length of drop pipe ft. capacity g.p.m. Type: <input type="checkbox"/> Submersible <input type="checkbox"/> Turbine <input type="checkbox"/> Jet <input type="checkbox"/> Reciprocating <input type="checkbox"/> Centrifugal <input type="checkbox"/> Other
WHITE LIME		40		98		18. Elevation: Topography: <input type="checkbox"/> Hill <input type="checkbox"/> Slope <input checked="" type="checkbox"/> Upland <input type="checkbox"/> Valley
TRACE OF WHITE SHALE		138		138		19. Remarks: THIS WELL IS FOR STOCK WATER ONLY. WELL FILLED TO 281' WITH CRUSHED ROCK + CEMENT.
WHITE LIME		7		138		20. Water well contractor's certification: This well was drilled under my jurisdiction and this report is true to the best of my knowledge and belief. SWANK WATER WELL DRILLING Business name Address RRL PRINCETON KANSAS Signed George H Swank Date 2/22/77 Authorized representative
BLUE LIME		3		145		
BLACK SHALE		7		148		
BLUE LIME		5		155		

Forward the white, blue and pink copies to the Department of Health and Environment

Form WWC-5

USE TYPEWRITER OR BALL
POINT PEN-PRESS FIRMLY,
PRINT CLEARLY.

WATER WELL RECORD
KSA 82a-1201-1215

Kansas Department of Health and
Environment-Division of Environment
(Water well Contractors)
Topeka, Kansas 66620

1. Location of well:		County	Fraction 1/4 1/4 1/4			Section number	Township number T S R	Range number E/W
2. Distance and direction from nearest town or city: Street address of well location if in city:						3. Owner of well: GEROLD PATTERSON R.R. or street: City, state, zip code:		
4. Locate with "X" in section below: N 1 Mile W E S 1 Mile						Sketch map: PAGE II		
5. Type and color of material						From	To	
GRAY SAND (LITTLE WATER)						40	160	200
BLUE LIME						5	200	205
LIGHT GRAY SHALE						10	205	215
WHITE LIME						50	215	265
BLUE SAND						5	265	270
GRAY SHALE						2	270	272
COAL						2	272	274
BLUE SHALE						13	274	287
BLUE LIME						3	287	290
RED SHALE						5	290	295
GRAY SHALE						15	295	310
BLUE SAND						10	310	320
GRAY SHALE						10	320	330
BLUE LIME						15	330	345
GRAY SHALE						3	345	348
(Use a second sheet if needed)								
18. Elevation:		19. Remarks:						
Topography: Hill Slope Upland Valley		20. Water well contractor's certification: This well was drilled under my jurisdiction and this report is true to the best of my knowledge and belief, SWANK WATER WELL DRILLING 107 Business name Address BRL PRINLETON KANSAS Signed George H Swank Date 3/22/77 Authorized representative						

Forward the white, blue and pink copies to the Department of Health and Environment

Form WWC-5

USE TYPEWRITER OR BALL
POINT PEN-PRESS FIRMLY,
PRINT CLEARLY.

WATER WELL RECORD
KSA 82a-1201-1215

Kansas Department of Health and
Environment-Division of Environment
(Water well Contractors)
Topeka, Kansas 66620

1. Location of well:		County	Fraction 1/4 1/4 1/4	Section number	Township number T S R	Range number E/W
2. Distance and direction from nearest town or city: Street address of well location if in city:				3. Owner of well: JEROLD PATTERSON R.R. or street: City, state, zip code:		
4. Locate with "X" in section below: N 1 Mile W E S 1 Mile		Sketch map: PAGE III		6. Bore hole dia. _____ in. Completion date _____ Well depth _____ ft.		
5. Type and color of material		From	To	7. _____ Cable tool _____ Rotary _____ Driven _____ Dug _____ Hollow rod _____ Jetted _____ Bored _____ Reverse rotary		
BLUE LIME		12	348	8. Use: _____ Domestic _____ Public supply _____ Industry _____ Irrigation _____ Air conditioning _____ Stock _____ Lawn _____ Oil field water _____ Other		
WHITE LIME		22	360	9. Casing: Material _____ Height: Above or below Threaded _____ Welded _____ Surface _____ in. RMP _____ PVC _____ Weight _____ lbs./ft. Dia. _____ in. to _____ ft. depth Wall Thickness: inches or Dia. _____ in. to _____ ft. depth gage No. _____		
GRAY SHALE		3	382	10. Screen: Manufacturer's name _____ Type _____ Dia. _____ Slot/gauze _____ Length _____ Set between _____ ft. and _____ ft. _____ ft. and _____ ft.		
COAL (LIGHT SALTY TASTE)		3	385	Gravel pack? _____ Size range of material _____		
GRAY SHALE		7	388	11. Static water level: _____ mo./day/yr. _____ ft. below land surface Date _____		
WELL FILLED WITH CRUSHED				12. Pumping level below land surfaces: _____ ft. after _____ hrs. pumping _____ g.p.m. _____ ft. after _____ hrs. pumping _____ g.p.m. Estimated maximum yield _____ g.p.m.		
ROCK + CEMENT + SAND TO 280 FT				13. Water sample submitted: _____ mo./day/yr. Yes _____ No _____ Date _____		
(Use a second sheet if needed)				14. Well head completion: _____ Pitless adapter _____ Inches above grade		
				15. Well grouted? _____ With: _____ Neat cement _____ Bentonite _____ Concrete _____ Depth: From _____ ft. to _____ ft.		
				16. Nearest source of possible contamination: ft. _____ Direction _____ Type _____ Well disinfected upon completion? _____ Yes _____ No		
				17. Pump: _____ Not installed Manufacturer's name _____ Model number _____ HP _____ Volts _____ Length of drop pipe _____ ft. capacity _____ g.p.m. Type: _____ Submersible _____ Turbine _____ Jet _____ Reciprocating _____ Centrifugal _____ Other		
18. Elevation:		19. Remarks:		20. Water well contractor's certification: This well was drilled under my jurisdiction and this report is true to the best of my knowledge and belief. Business name _____ License No. 107 Address _____ Signed George H. Swank Date 2/22/77 Authorized representative		
Topography: _____ Hill _____ Slope _____ Upland _____ Valley						

Forward the white, blue and pink copies to the Department of Health and Environment

Form WWC-5