USE TYPEWRITER OR BALL POINT PEN-PRESS FIRMLY, PRINT CLEARLY.

WATER WELL RECORD
KSA 82a-1201-1215

Kansas Department of Health and Environment-Division of Environment
(Water well Contractors)
Topeka, Kansas 66620

1. Location of well:	County	Fraction	Section number	Township number	Range number
	Anderson	1/4 1/4 NW 1/4	7	T 21 S	R 19 E/W

2. Distance and direction from nearest town or city:

Street address of well location if in city:

3. Owner of well: Tobe Yoder
R.R. or street: R.R.
City, state, zip code: garnett Kansas 66032

4. Locate with "X" in section below:

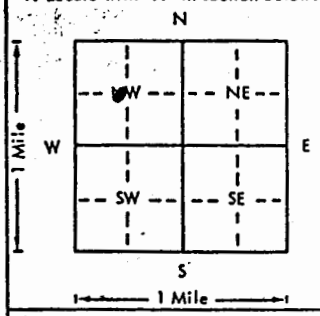

Sketch map:

6. Bore hole dia. 8¾ in. Completion date _____
Well depth _____ ft.

7. X Cable tool __ Rotary __ Driven __ Dug
__ Hollow rod __ Jetted __ Bored __ Reverse rotary

8. Use: X Domestic __ Public supply __ Industry
__ Irrigation __ Air conditioning X Stock
__ Lawn __ Oil field water __ Other

9. Casing: Material PVC
Threaded ____ Welded ____
RMP ____ PVC ✓
Dia. ____ in. to ____ ft. depth
Dia. ____ in. to ____ ft. depth
Height: Above or below Surface ____ in.
Weight ____ lbs./ft.
Wall Thickness: inches or gage No. .316

10. Screen: Manufacturer's name ROBINTECH
Type PVC 200 Dia. 6"
Slot/gauze ____ Length 20
Set between ____ ft. and ____ ft.
____ ft. and ____ ft.
Gravel pack? ____ Size range of material none

11. Static water level: mo./day/yr.
____ ft. below land surface Date ____

12. Pumping level below land surfaces:
____ ft. after ____ hrs. pumping ____ g.p.m.
____ ft. after ____ hrs. pumping ____ g.p.m.
Estimated maximum yield ____ g.p.m.

13. Water sample submitted: mo./day/yr.
____ Yes ____ No Date ____

14. Well head completion:
____ Pitless adapter ____ Inches above grade

15. Well grouted? no
With: ____ Neat cement ____ Bentonite ____ Concrete
Depth: From ____ ft. to ____ ft.

16. Nearest source of possible contamination:
ft. 30 Direction SOUTH Type POND
Well disinfected upon completion? ✓ Yes ____ No

17. Pump: ____ Not installed
Manufacturer's name WIND MILL
Model number ____ HP ____ Volts ____
Length of drop pipe ____ ft. capacity ____ g.p.m.
Type:
____ Submersible ____ Turbine
____ Jet ____ Reciprocating
____ Centrifugal ____ Other

5. Type and color of material

	From	To
Cleaned old well out 8¼"		
Pulled 7" galv casing + Replaced with		
Robintech 6"		

(Use a second sheet if needed)

18. Elevation:

Topography:
____ Hill
____ Slope
____ Upland
✓ Valley

19. Remarks: There is no Concention with the well from the Pond as water comes in the well from East at 25 ft. Has 8" steel Casing cemented in in a grade A dairy approved Pit with well seal on it.

20. Water well contractor's certification:
This well was drilled under my jurisdiction and this report is true to the best of my knowledge and belief.
Swank water Well drilling 107
Business name License No.
Address R.R. I Princeton, Kansas
Signed George H. Swank Date ____
Authorized representative

T ____ R ____ E W Sec ____ 1/4 ____ 1/4 ____ 1/4 ____

Forward the white, blue and pink copies to the Department of Health and Environment

Form WWC-5