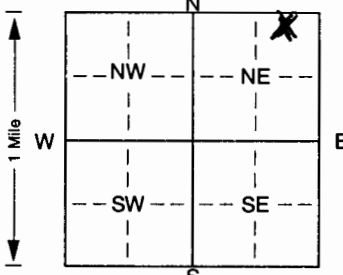


1 LOCATION OF WATER WELL: Fraction Ne 1/4 Ne 1/4 Ne 1/4 Section Number 9 Township Number T 21 S Range Number R 2 E
 County: Marion

Distance and direction from nearest town or city street address of well if located within city?

7 S 2 W Hillsboro

2 WATER WELL OWNER: Reginald Hiebert
 RR#, St. Address, Box # : RR2 Board of Agriculture, Division of Water Resources
 City, State, ZIP Code : Hillsboro, KS 67063 Application Number:

3 LOCATE WELL'S LOCATION WITH AN "X" IN SECTION BOX:

 4 DEPTH OF COMPLETED WELL... 5.5 ft. ELEVATION:
 Depth(s) Groundwater Encountered 1. 1.5 ft. 2. ft. 3. ft.
 WELL'S STATIC WATER LEVEL... 1.5 ft. below land surface measured on mo/day/yr 5-9-01
 Pump test data: Well water was ft. after hours pumping gpm
 Est. Yield 10-15 gpm: Well water was ft. after hours pumping gpm
 Bore Hole Diameter... 9 in. to 2.0 ft., and 7.5 in. to 5.6 ft.
 WELL WATER TO BE USED AS: 5 Public water supply 8 Air conditioning 11 Injection well
 1 Domestic 3 Feedlot 6 Oil field water supply 9 Dewatering 12 Other (Specify below)
 2 Irrigation 4 Industrial 7 Domestic (lawn & garden) 10 Monitoring well
 Was a chemical/bacteriological sample submitted to Department? Yes. No. Y; If yes, mo/day/yr sample was submitted
 Water Well Disinfected? Yes Y No

5 TYPE OF BLANK CASING USED: 5 Wrought iron 8 Concrete tile CASING JOINTS: Glued. X Clamped.
 1 Steel 3 RMP (SR) 6 Asbestos-Cement 9 Other (specify below) Welded
 2 PVC 4 ABS 7 Fiberglass Threaded
 Blank casing diameter... 5 in. to 1.5 ft., Dia... 5 in. to 4.5 ft., Dia... in. to ft.
 Casing height above land surface... in., weight lbs./ft. Wall thickness or gauge No.
 TYPE OF SCREEN OR PERFORATION MATERIAL: 7 PVC 10 Asbestos-cement
 1 Steel 3 Stainless steel 5 Fiberglass 8 RMP (SR) 11 Other (specify)
 2 Brass 4 Galvanized steel 6 Concrete tile 9 ABS 12 None used (open hole)
 SCREEN OR PERFORATION OPENINGS ARE: 5 Gauzed wrapped 8 Saw cut 11 None (open hole)
 1 Continuous slot 3 Mill slot 6 Wire wrapped 9 Drilled holes
 2 Louvered shutter 4 Key punched 7 Torch cut 10 Other (specify) ft.
 SCREEN-PERFORATED INTERVALS: From... 1.5 ft. to 2.0 ft., From... 4.5 ft. to 5.6 ft.
 From... ft. to ft., From... ft. to ft.
 GRAVEL PACK INTERVALS: From... ft. to ft., From... ft. to ft.
 From... ft. to ft., From... ft. to ft.

6 GROUT MATERIAL: 1 Neat cement 2 Cement grout 3 Bentonite 4 Other
 Grout intervals: From... 0 ft. to 12 ft., From... ft. to ft., From... ft. to ft.
 What is the nearest source of possible contamination:
 1 Septic tank 4 Lateral lines 7 Pit privy 10 Livestock pens 14 Abandoned water well
 2 Sewer lines 5 Cess pool 8 Sewage lagoon 11 Fuel storage 15 Oil well/Gas well
 3 Watertight sewer lines 6 Seepage pit 9 Feedyard 12 Fertilizer storage 16 Other (specify below)
 13 Insecticide storage
 Direction from well? S How many feet? 150

FROM	TO	LITHOLOGIC LOG	FROM	TO	PLUGGING INTERVALS
<u>0</u>	<u>12</u>	<u>Clay</u>			<u>Water was to</u>
<u>12</u>	<u>17</u>	<u>Shale (gravel)</u>			<u>Shallow to Grout</u>
<u>17</u>	<u>45</u>	<u>Gray Shale</u>			<u>20'</u>
<u>45</u>	<u>46</u>	<u>Some Water</u>			
<u>46</u>	<u>56</u>	<u>Hard Gray Shale</u>			

7 CONTRACTOR'S OR LANDOWNER'S CERTIFICATION: This water well was (1) constructed, (2) reconstructed, or (3) plugged under my jurisdiction and was completed on (mo/day/year) 5-9-01 and this record is true to the best of my knowledge and belief. Kansas Water Well Contractor's Licence No. 180 This Water Well Record was completed on (mo/day/yr) 5-10-01 under the business name of Backhus Drilling by (signature) Paul H. Backhus