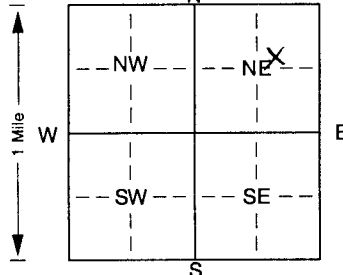


1 LOCATION OF WATER WELL: Fraction SW 1/4 NE 1/4 NE 1/4 Section Number 12 Township Number T 21 S Range Number R 21 EW
 County: Linn

Distance and direction from nearest town or city street address of well if located within city?

1 mile NW of Centerville

2 WATER WELL OWNER: Dwight Gerrell
 RR#, St. Address, Box #: 2443 W 14th Road
 City, State, ZIP Code: Centerville, Mo 646014
 Board of Agriculture, Division of Water Resources
 Application Number:

3 LOCATE WELL'S LOCATION WITH AN "X" IN SECTION BOX:

 4 DEPTH OF COMPLETED WELL: 170 ft. ELEVATION:
 Depth(s) Groundwater Encountered 1. 55 ft. 2. 132 ft. 3. 163 ft.
 WELL'S STATIC WATER LEVEL ± 60 ft. below land surface measured on mo/day/yr 12/19/03
 Pump test data: Well water was _____ ft. after _____ hours pumping _____ gpm
 Est. Yield ± 3 gpm: Well water was _____ ft. after _____ hours pumping _____ gpm
 Bore Hole Diameter: 10 in. to 170 ft. and _____ in. to _____ ft.
 WELL WATER TO BE USED AS:
 1 Domestic (circled) 3 Feedlot 6 Oil field water supply 9 Dewatering 12 Other (Specify below)
 2 Irrigation 4 Industrial 7 Domestic (lawn & garden) 10 Monitoring well
 Was a chemical/bacteriological sample submitted to Department? Yes. _____ No. ✓; If yes, mo/day/yr sample was submitted
 Water Well Disinfected? Yes ✓ No _____

5 TYPE OF BLANK CASING USED:
 1 Steel (circled) 3 RMP (SR) 5 Wrought iron 8 Concrete tile CASING JOINTS: Glued ✓ Clamped _____
 2 PVC (circled) 4 ABS 6 Asbestos-Cement 9 Other (specify below) Welded _____
 7 Fiberglass Threaded _____
 Blank casing diameter _____ in. to 60 ft., Dia. 5 in. to 100 ft., Dia. 5 in. to 150 ft.
 Casing height above land surface: 18 in., weight Sdr 21 lbs./ft. Wall thickness or gauge No. 200 PSI
 TYPE OF SCREEN OR PERFORATION MATERIAL:
 1 Steel 3 Stainless steel 5 Fiberglass 7 PVC (circled) 10 Asbestos-cement
 2 Brass 4 Galvanized steel 6 Concrete tile 8 RMP (SR) 11 Other (specify) _____
 9 ABS 12 None used (open hole)
 SCREEN OR PERFORATION OPENINGS ARE:
 1 Continuous slot 3 Mill slot 5 Gauzed wrapped 8 Saw cut (circled) 11 None (open hole)
 2 Louvered shutter 4 Key punched 6 Wire wrapped 9 Drilled holes
 7 Torch cut 10 Other (specify) _____ ft.
 SCREEN-PERFORATED INTERVALS: From 60 ft. to 80 ft., From 100 ft. to 120 ft.
 From 150 ft. to 160 ft., From _____ ft. to _____ ft.
 GRAVEL PACK INTERVALS: From 30 ft. to 170 ft., From _____ ft. to _____ ft.
 From _____ ft. to _____ ft., From _____ ft. to _____ ft.

6 GROUT MATERIAL: 1 Neat cement 2 Cement grout 3 Bentonite (circled) 4 Other _____
 Grout Intervals: From 0 ft. to 30 ft., From _____ ft. to _____ ft., From _____ ft. to _____ ft.
 What is the nearest source of possible contamination:
 1 Septic tank (circled) 4 Lateral lines 7 Pit privy 10 Livestock pens 14 Abandoned water well
 2 Sewer lines 5 Cess pool 8 Sewage lagoon 11 Fuel storage 15 Oil well/Gas well
 3 Watertight sewer lines 6 Seepage pit 9 Feedyard 12 Fertilizer storage 16 Other (specify below)
 13 Insecticide storage
 Direction from well? _____ How many feet? +150'

FROM	TO	LITHOLOGIC LOG	FROM	TO	PLUGGING INTERVALS
0	5	Sandy clay			
5	9	Broken limestone			
9	40	Limestone			
40	51	Shale			
51	63	Limestone (water)			
63	88	Shale			
88	94	Limestone			
94	95	Slate			
95	110	Shale			
110	125	Limestone			
125	132	Shale			
132	141	Limestone (water)			
141	145	Slate (water)			
145	170	Shale			

7 CONTRACTOR'S OR LANDOWNER'S CERTIFICATION: This water well was (1) constructed, (2) reconstructed, or (3) plugged under my jurisdiction and was completed on (mo/day/year) 12/19/03 and this record is true to the best of my knowledge and belief. Kansas Water Well Contractor's Licence No. 595 This Water Well Record was completed on (mo/day/yr) 12/26/03 under the business name of Jesse Yoakum Well Drilling by (signature) [Signature]