(2)

WATER WELL RECORD Form WWC-5 KSA 82a-1212 ID No. _____

1 LOCATION OF WATER WELL: County: Linn	Fraction: SE ¼ ~~SW~~ NW ¼ ~~NW~~ ¼	Section Number: 17	Township Number: T 21 S	Range Number: R 22 (E) W

Distance and direction from nearest town or city street address of well if located within city?
Hwy 1077 Centerville,Ks.

2 WATER WELL OWNER: Keith & Tammy Brownback
RR#, St. Address, Box #: P.O. Box 57
City, State, ZIP Code: Centerville,Ks. 66014

Board of Agriculture, Division of Water Resources Application Number:

3 LOCATE WELL'S LOCATION WITH AN "X" IN SECTION BOX:

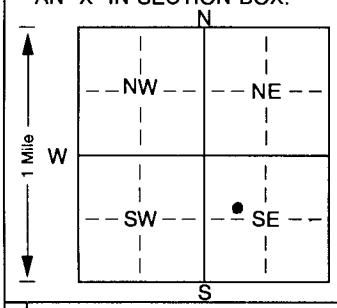

4 DEPTH OF COMPLETED WELL 10 ft. ELEVATION:
Depth(s) Groundwater Encountered 1. 6 ft. 2. ft. 3. ft.
WELL'S STATIC WATER LEVEL 6.40 ft. below land surface measured on mo/day/yr 5/23/00
Pump test data: Well water was ft. after hours pumping gpm
Est. Yield gpm Well water was 7 ft. after 5½ hours pumping gpm
Bore Hole Diameter 8½ in. to 7 ft., and 5½ in. to 10 ft.
WELL WATER TO BE USED AS: 5 Public water supply 8 Air conditioning 11 Injection well
1 Domestic 3 Feedlot 6 Oil field water supply 9 Dewatering 12 Other (Specify below)
2 Irrigation 4 Industrial 7 Domestic (lawn & garden) (10) Monitoring well
Was a chemical/bacteriological sample submitted to Department? Yes. No. ; If yes, mo/day/yrs sample was submitted
Water Well Disinfected? Yes (No)

5 TYPE OF BLANK CASING USED: 5 Wrought iron 8 Concrete tile CASING JOINTS: Glued. Clamped.
1 Steel 3 RMP (SR) 6 Asbestos-Cement 9 Other (specify below) Welded
(2 PVC) 4 ABS 7 Fiberglass Threaded X
Blank casing diameter 2 3/8 in. to 5 ft., Dia in. to ft., Dia in. to SDR 13 ft.
Casing height above land surface FLUSH MOUNT in., weight lbs./ft. Wall thickness or gauge No. SCh 40
TYPE OF SCREEN OR PERFORATION MATERIAL: (7 PVC) 10 Asbestos-cement
1 Steel 3 Stainless steel 5 Fiberglass 8 RMP (SR) 11 Other (specify)
2 Brass 4 Galvanized steel 6 Concrete tile 9 ABS 12 None used (open hole)
SCREEN OR PERFORATION OPENINGS ARE: 5 Gauzed wrapped 8 Saw cut 11 None (open hole)
1 Continuous slot (3 Mill slot) 6 Wire wrapped 9 Drilled holes
2 Louvered shutter 4 Key punched 7 Torch cut 10 Other (specify) ft.
SCREEN-PERFORATED INTERVALS: From 10 ft. to 5 ft., From ft. to. ft.
From ft. to ft., From ft. to. ft.
GRAVEL PACK INTERVALS: From 10 ft. to 4 ft., From ft. to. ft.
From ft. to ft., From ft. to. ft.

6 GROUT MATERIAL: 1 Neat cement (2) Cement grout (3) Bentonite 4 Other
Grout Intervals: From 0 ft. to 2 ft., From 2 ft. to 4 ft., From ft. to. ft.
What is the nearest source of possible contamination: 10 Livestock pens 14 Abandoned water well
1 Septic tank 4 Lateral lines 7 Pit privy (11) Fuel storage 15 Oil well/Gas well
2 Sewer lines 5 Cess pool 8 Sewage lagoon 12 Fertilizer storage 16 Other (specify below)
3 Watertight sewer lines 6 Seepage pit 9 Feedyard 13 Insecticide storage
Direction from well? ~~NORTHWEST~~ SOUTHWEST How many feet? 60

FROM	TO	LITHOLOGIC LOG	FROM	TO	PLUGGING INTERVALS
0	2.25	Grass-brn clay, dry-damp, no odor.			
2.25	7	Red brn clay, moist, firm,			
		no odor, some chert gravel.			
7	10	Limestone, crystalline,			
		hard, dry, white.			
					Flush mt. ok'd by Don Taylor

7 CONTRACTOR'S OR LANDOWNER'S CERTIFICATION: This water well was (1) constructed, (2) reconstructed, or (3) plugged under my jurisdiction and was completed on (mo/day/year) 4-18-00 and this record is true to the best of my knowledge and belief. Kansas Water Well Contractor's Licence No. 538 This Water Well Record was completed on (mo/day/yr) 7-5-00
under the business name of JB Environmental Drilling by (signature) James V Bieber

INSTRUCTIONS: Use typewriter or ball point pen. *PLEASE PRESS FIRMLY* and *PRINT* clearly. Please fill in blanks, underline or circle the correct answers. Send top three copies to Kansas Department of Health and Environment, Bureau of Water, Topeka, Kansas 66620-0001. Telephone 785-296-5524. Send one to WATER WELL OWNER and retain one for your records. Fee of $5.00 for each constructed well.