(8)

WATER WELL RECORD Form WWC-5 KSA 82a-1212 ID No. _____

1 LOCATION OF WATER WELL: County: Linn	Fraction: SE ¼ ~~SW~~ NW ¼ ~~NW~~ SE ¼	Section Number: 17	Township Number: T 21 S	Range Number: R 22 (E) W

Distance and direction from nearest town or city street address of well if located within city?
Hwy 1077 Centerville,Ks.

2 WATER WELL OWNER: Keith & Tammy Brownback
RR#, St. Address, Box #: P.O. Box 57
City, State, ZIP Code: Centerville,Ks. 66014

Board of Agriculture, Division of Water Resources Application Number:

3 LOCATE WELL'S LOCATION WITH AN "X" IN SECTION BOX:

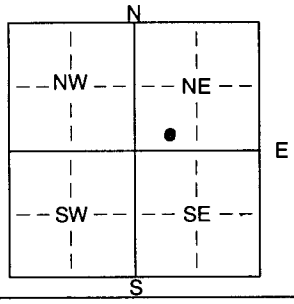

4 DEPTH OF COMPLETED WELL 10 ft. ELEVATION:
Depth(s) Groundwater Encountered 1 7 ft. 2. ft. 3. ft.
WELL'S STATIC WATER LEVEL 7.75 ft. below land surface measured on mo/day/yr
Pump test data: Well water was ft. after hours pumping gpm
Est. Yield gpm: Well water was ft. after 5½ hours pumping gpm
Bore Hole Diameter 8½ in. to 8 ft., and 5½ in. to 10 ft.
WELL WATER TO BE USED AS: 1 Domestic 2 Irrigation 3 Feedlot 4 Industrial 5 Public water supply 6 Oil field water supply 7 Domestic (lawn & garden) 8 Air conditioning 9 Dewatering 10 Monitoring well 11 Injection well 12 Other (Specify below)
Was a chemical/bacteriological sample submitted to Department? Yes No ; If yes, mo/day/yrs sample was submitted
Water Well Disinfected? Yes No

5 TYPE OF BLANK CASING USED: 1 Steel (2 PVC) 3 RMP (SR) 4 ABS 5 Wrought iron 6 Asbestos-Cement 7 Fiberglass 8 Concrete tile 9 Other (specify below)
CASING JOINTS: Glued Clamped Welded Threaded X
Blank casing diameter 2 3/8 in. to 5 ft., Dia in. to ft., Dia in. to SDR 13 ft.
Casing height above land surface FLUSH MOUNT in., weight lbs./ft. Wall thickness or gauge No. SCh 40
TYPE OF SCREEN OR PERFORATION MATERIAL: 1 Steel 2 Brass 3 Stainless steel 4 Galvanized steel 5 Fiberglass 6 Concrete tile (7 PVC) 8 RMP (SR) 9 ABS 10 Asbestos-cement 11 Other (specify) 12 None used (open hole)
SCREEN OR PERFORATION OPENINGS ARE: (1 Continuous slot) 2 Louvered shutter (3 Mill slot) 4 Key punched 5 Gauzed wrapped 6 Wire wrapped 7 Torch cut 8 Saw cut 9 Drilled holes 10 Other (specify) 11 None (open hole)
SCREEN-PERFORATED INTERVALS: From 10 ft. to 5 ft., From ft. to ft.
From ft. to 4 ft., From ft. to ft.
GRAVEL PACK INTERVALS: From 10 ft. to 4 ft., From ft. to ft.
From ft. to ft., From ft. to ft.

6 GROUT MATERIAL: 1 Neat cement 2 Cement grout (3 Bentonite) 4 Other
Grout Intervals: From 0 ft. to 2 ft., From 2 ft. to 4 ft., From ft. to ft.
What is the nearest source of possible contamination:
1 Septic tank 2 Sewer lines 3 Watertight sewer lines 4 Lateral lines 5 Cess pool 6 Seepage pit 7 Pit privy 8 Sewage lagoon 9 Feedyard 10 Livestock pens (11 Fuel storage) 12 Fertilizer storage 13 Insecticide storage 14 Abandoned water well 15 Oil well/Gas well 16 Other (specify below)
Direction from well? ~~SOUTH~~ NORTH How many feet? 145

FROM	TO	LITHOLOGIC LOG	FROM	TO	PLUGGING INTERVALS
0	3	Grass-dk brn loose clay soil,			
		root frag.,dry, no odor.			
3	8	red brn clay, moist w/some			
		cherty gravel, firm, no odor.			
8	10	Limestone, gray/white, hard,			
		dry, crystalline.			
					Flush mt. ok'd by Don Taylor

7 CONTRACTOR'S OR LANDOWNER'S CERTIFICATION: This water well was (1) constructed, (2) reconstructed, or (3) plugged under my jurisdiction and was completed on (mo/day/year) 4-19-00 and this record is true to the best of my knowledge and belief. Kansas Water Well Contractor's Licence No. 539 This Water Well Record was completed on (mo/day/yr) 7-5-00
under the business name of JB Environmental Drilling by (signature) James V. Bieber

INSTRUCTIONS: Use typewriter or ball point pen. *PLEASE PRESS FIRMLY* and *PRINT* clearly. Please fill in blanks, underline or circle the correct answers. Send top three copies to Kansas Department of Health and Environment, Bureau of Water, Topeka, Kansas 66620-0001. Telephone 785-296-5524. Send one to WATER WELL OWNER and retain one for your records. Fee of $5.00 for each constructed well.