

WATER WELL RECORD Form WWC-5 KSA 82a-1212


1 LOCATION OF WATER WELL: Fraction Section Number Township Number Range Number
 COUNTY: FORD SW 1/4 SW 1/4 SW 1/4 16 T 25 S R 24

DRL
5/17/2010

Distance and direction from nearest town or city street address of well if located within city?
 FROM DODGE CITY = 3 N. ON 14TH - E. ON GARNETT TO 114 RD.3N.

2 WATER WELL OWNER: SCOTT, SPENCER Board of Agriculture, Division of Water Resources
 RR#, St. Address, Box #: 11402 114 RD. Application Number:
 City, State, ZIP code: WRIGHT, KS 67882-

3 LOCATE WELL'S LOCATION WITH AN "X" IN SECTION BOX:

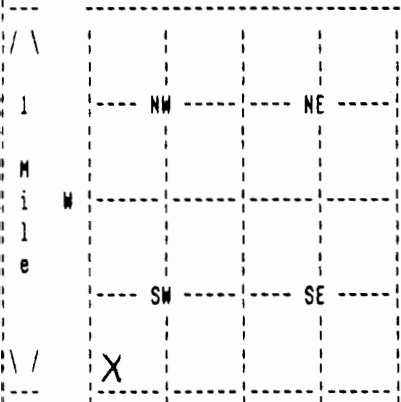

4 DEPTH OF COMPLETED WELL 325 ELEVATION: 0
 Depth(s) Groundwater Encountered 1. 0 ft. 2. 0 ft. 3. 0 ft.

WELL'S STATIC WATER LEVEL 36 ft. below land surface measured on mo/day/yr 04/08/10
 Pump test data: Well water was 0 ft. after 0 hours pumping 0 gpm

Estimated Yield 10 gpm: Well water was 0 ft. after 0 hours pumping 0 gpm

Bore Hole Diameter 10 in. to 325 ft., and in. to 0 ft.

WELL WATER TO BE USED AS: DOMESTIC

Was a chemical/bacteriological sample submitted to department? No ;
 If yes, mo/day/yr sample was submitted Water well disinfected? Yes

5 TYPE OF BLANK CASING USED: CERTA LOC CASIN CASING JOINTS: CERTA-LOC
 Blank casing diameter 5 in. to 325 ft., Dia in. to 0 ft., Dia in. to 0 ft.
 Casing height above land surface 12 in., weight 200 lbs/ft. Wall thickness or gauge No. 21
 TYPE OF SCREEN OR PERFORATION MATERIAL: PVC
 SCREEN OR PERFORATION OPENINGS ARE: SAW CUT

SCREEN PERFORATED INTERVALS: From 40 ft. to 80 ft., From 0 ft. to 0 ft.
 From 280 ft. to 320 ft., From 0 ft. to 0 ft.
 GRAVEL PACK INTERVALS: From 25 ft. to 100 ft., From 0 ft. to 0 ft.
 From 120 ft. to 325 ft., From 0 ft. to 0 ft.

6 GROUT MATERIAL BENTONITE
 Grout Intervals: From 6 ft. to 25 ft., From 0 ft. to 120 ft., From 0 ft. to 0 ft.
 What is the nearest source of possible contamination: NONE
 Direction from well? How many feet? 0

FROM	TO	LITHOLOGIC LOG	FROM	TO	PLUGGING INTERVALS
0	20	01 TOPSOIL 14 WHITE CLAY 27 ROCK			
20	36	27 ROCK 35 CALACHIE			
36	60	14 WHITE CLAY 07 BLUE SHALE			
60	80	07 BLUE SHALE			
80	100	36 BLUE CLAY			
100	120	36 BLUE CLAY 31 SHALE			
120	140	36 BLUE CLAY 16 GRAY CLAY			
140	180	16 GRAY CLAY			
180	200	16 GRAY CLAY 36 BLUE CLAY			
200	220	16 GRAY CLAY 29 SANDSTONE 19 LAYERS			

7 CONTRACTOR'S OR LANDOWNER'S CERTIFICATION: This water well was Constructed under my jurisdiction and was completed on (mo/day/year) 04/09/10 and this record is true to the best of my knowledge and belief. Kansas Water Well Contractor's License No. 179 This Water Well Record was completed on (mo/day/yr) 04/21/10 under the business name of JOE'S WELL SERVICE, INC. by (signature) *Justin Cook*

(Continued)

WATER WELL RECORD Form MWC-5 KSA 82a-1212

1 LOCATION OF WATER WELL: Fraction Section Number Township Number Range Number
COUNTY: FORD SW 1/4 SW 1/4 SW 1/4 16 T 25 S R 24 E

2 WATER WELL OWNER: SCOTT, SPENCER
RR#, St. Address, Box #: 11402 114 RD. Board of Agriculture, Division of Water Resources
City, State, ZIP code : WRIGHT, KS 67882- Application Number:

FROM	TO	LITHOLOGIC LOG
220	260	16 GRAY CLAY
260	280	16 GRAY CLAY 26 RED CLAY
280	300	16 GRAY CLAY 29 SANDSTONE
300	320	29 SANDSTONE 16 GRAY CLAY
320	360	16 GRAY CLAY
360	460	16 GRAY CLAY 08 ROCK LAYERS

7 CONTRACTOR'S OR LANDOWNER'S CERTIFICATION: This water well was Constructed under my jurisdiction and was completed on (mo/day/year) 04/09/10 and this record is true to the best of my knowledge and belief. Kansas Water Well Contractor's License No. 179 This Water Well Record was completed on (mo/day/yr) 04/21/10 under the business name of JOE'S WELL SERVICE, INC. by (signature) *Judith Creek*