

1 LOCATION OF WATER WELL:	Fraction	Section Number	Township Number	Range Number
County: <b>Linn</b>	<b>NE ¼ NE ¼ NW ¼</b>	<b>31</b>	<b>21</b>	<b>25-East</b>

Distance and direction from nearest town or city street address of well if located within city?


**600 Magnolia Street, Pleasanton, Kansas**2 WATER WELL OWNER: **Pete's of Erie, Inc.**RR#, St. Address, Box # **P.O. Box 875**

Board of Agriculture, Division of Water Resources

City, State, ZIP Code : **Parsons, Kansas 67357**

Application Number:

3 MARK WELL'S LOCATION WITH AN "X" IN SECTION BOX:

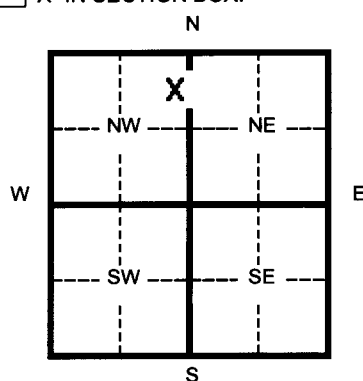

4

DEPTH OF WELL **13.0** ft.WELL'S STATIC WATER LEVEL **3.90** ft.

WELL WAS USED AS:

1 Domestic

5 Public Water Supply

9 Dewatering

2 Irrigation

6 Oil Field Water Supply

☒ 10 Monitoring Well

3 Feedlot

7 Lawn and Garden (domestic)

11 Injection Well

4 Industrial

8 Air Conditioning

12 Other

Was a chemical/bacteriological sample submitted to Department? Yes No ☒

If yes, mo/day/yr sample was submitted

Water Well Disinfected: Yes No ☒

5 TYPE OF BLANK CASING USED:

1 Steel

3 RMP (SR)

5 Wrought

7 Fiberglass

9 Other (specify below)

☒ 2 PVC

4 ABC

6 Asbestos-Cement

8 Concrete Tile

Blank casing diameter **2.375** in.Was casing pulled? Yes ☒ NoIf yes, how much? **13.0'**Casing height above or below land surface **Unknown** in.**Well overdrilled to 13.0'**

6 GROUT PLUG MATERIAL:

1 Neat cement

2 Cement grout

☒ 3 Bentonite☒ 4 Other**Soils/Gravel**Grout Plug Intervals From **13.0** ft. to **1.0** ft. From **1.0** ft. to **0.0** ft. From ft. to ft.

What is the nearest source of possible contamination:

1 Septic tank

6 Seepage pit

☒ 11 Fuel storage

16 Other (specify below)

2 Sewer lines

7 Pit privy

12 Fertilizer storage

3 Watertight sewer lines

8 Sewage lagoon

13 Insecticide storage

4 Lateral lines

9 Feedyard

14 Abandoned water well

5 Cess Pool

10 Livestock pens

15 Oil well/ Gas well

Direction from well? **Northwest**How many feet? **100**

FROM	TO	CODE	PLUGGING MATERIALS
0.0	1.0		Compacted soils and gravel
1.0	13.0		Bentonite chips

7

CONTRACTOR'S OR LANDOWNER'S CERTIFICATION: This water well was plugged under my jurisdiction and was completed on (mo/day/yr) **04/28/05** and this record is true to the best of my knowledge and belief. KansasWater Well Contractor's License No. **692**

This Water Well Record was completed on (mo/day/yr)

**04/06/05**

under the business name of

**Quad State Services, Inc.**

by (signature)

INSTRUCTIONS: Please fill in blanks and circle the correct answers. Send three copies to Kansas Department of Health and Environment, Bureau of Water, 1000 S W Jackson St., Ste. 420, Topeka, Kansas 66620-0001. Telephone: 785-296-3565. Send one to Water Well Owner and retain one for your records.