


#3 @ Approx 10 + 175.44 Rest Area

WATER WELL PLUGGING RECORD Form WWC-5P KSA 82a-1212 ID NO.

1 LOCATION OF WATER WELL: County: Linn Fraction: N 1/2 1/4 1/4 Section Number: 004 Township Number: 215 Range Number: 25 EX

Distance and direction from nearest town or city street address of well if located within city?
6 miles North of Pleasanton, Ks South of Hwy 52

2 WATER WELL OWNER: KDOT Area 2 Global Positioning Systems (decimal degrees, min. of 4 digits)
 RR#, St. Address, Box #: 507 N. Maple Latitude: _____
 City, State ZIP Code: Garnett, Ks 66032-1081 Longitude: _____
 Elevation: _____
 Datum: _____
 Data Collection Method: _____

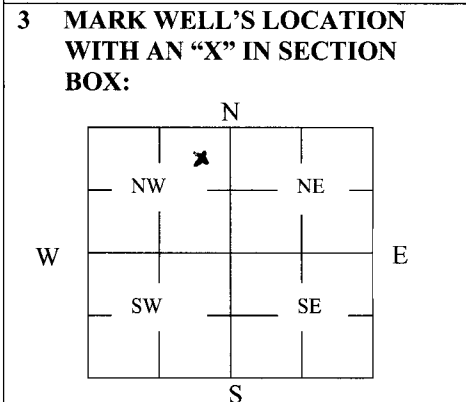

4 DEPTH OF WELL 12 ft.
 WELL'S STATIC WATER LEVEL 0 ft.
 WELL WAS USED AS:
 1 Domestic Not being used. 5 Public Water Supply 9 Dewatering
 2 Irrigation 6 Oil Field Water Supply 10 Monitoring
 3 Feedlot 7 Domestic (Lawn & Garden) 11 Injection Well
 4 Industrial 8 Air Conditioning 12 Other _____
 Was a chemical/bacteriological sample submitted to Department? Yes _____ No K

5 TYPE OF BLANK CASING USED:
 1 Steel 3 RMP (SR) 5 Wrought 7 Fiberglass 9 Other (Specify below)
 2 PVC 4 ABS 6 Asbestos-Cement 8 Concrete Tile Rock
 Blank casing diameter 48 in. Was casing pulled? Yes _____ No X If yes, how much _____
 Casing height above or below land surface 0 in.

6 GROUT PLUG MATERIAL: 1 Neat cement 2 Cement grout 3 Bentonite 4 Other _____
 Grout Plug Intervals: From 12 3/4 ft. to 2 ft., From 2 ft. to 1 ft., From _____ to _____ ft.
 What is the nearest source of possible contamination:
 1 Septic tank 6 Seepage pit 11 Fuel Storage 16 Other (specify below)
 2 Sewer lines 7 Pit privy 12 Fertilizer storage unknown
 3 Watertight sewer lines 8 Sewage lagoon 13 Insecticide storage _____
 4 Lateral lines 9 Feedyard 14 Abandoned water well Direction from well? _____
 5 Cess pool 10 Livestock pens 15 Oil well/Gas well How many feet? _____

| FROM | TO | PLUGGING MATERIALS | FROM | TO | PLUGGING MATERIALS |
|------------|-----------|--------------------|------|----|--------------------|
| <u>12'</u> | <u>2'</u> | <u>3/4 Rock</u> | | | |
| <u>2'</u> | <u>1'</u> | <u>Cement</u> | | | |
| | | | | | |
| | | | | | |
| | | | | | |
| | | | | | |

7 CONTRACTOR'S OR LANDOWNER'S CERTIFICATION: This water well was plugged under my jurisdiction and was completed on (mo/day/year) 01/21/2008 and this record is true to the best of my knowledge and belief. Kansas Water Well Contractor's License No. 591. This Water Well Record was completed on (mo/day/year) 01/31/08 under the business name of K-W Oil Well Service, Inc by (signature) [Signature]

INSTRUCTIONS: Use typewriter or ballpoint pen. Please press firmly and print clearly. Please fill in blanks, underline or circle the correct answers. Send top three copies to Kansas Department of Health and Environment, Bureau of Water, Geology Section, 1000 SW Jackson St., Ste. 420, Topeka, Kansas 66612-1367. Telephone: 785/296-5522. Send one to Water Well Owner and retain one for your records. Visit us at <http://www.kdheks.gov/geo/waterwells>.