


1 LOCATION OF WATER WELL: Fraction SE 1/4 NE 1/4 NW 1/4 Section Number 12 Township Number 21 Range Number 25 EW
 County: Winn

Distance and direction from nearest town or city street address of well if located within city?

26273 East 1500 Road Pleasanton, Ks.

2 WATER WELL OWNER: U.S. Fish & Wildlife Service
 RR#, St. Address, Box #: 24141 Ks. Hwy 52
 City, State ZIP Code: Pleasanton, KS 66075
 Global Positioning Systems (decimal degrees, min. of 4 digits)
 Latitude: 38 14 34.6
 Longitude: 94 32 14.2
 Elevation: _____
 Datum: _____
 Data Collection Method: Garmin Etrex

3 MARK WELL'S LOCATION WITH AN "X" IN SECTION BOX:

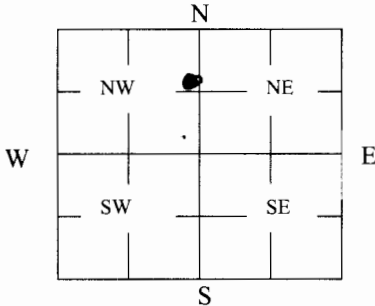

4 DEPTH OF WELL 86' ft.

WELL'S STATIC WATER LEVEL 19' 6" ft

WELL WAS USED AS:

- | | | |
|---|----------------------------|-------------------|
| <input checked="" type="radio"/> 1 Domestic | 5 Public Water Supply | 9 Dewatering |
| 2 Irrigation | 6 Oil Field Water Supply | 10 Monitoring |
| 3 Feedlot | 7 Domestic (Lawn & Garden) | 11 Injection Well |
| 4 Industrial | 8 Air Conditioning | 12 Other _____ |

Was a chemical/bacteriological sample submitted to Department? Yes _____ No

5 TYPE OF BLANK CASING USED:

<input checked="" type="checkbox"/> 1 Steel	3 RMP (SR)	5 Wrought	7 Fiberglass	9 Other (Specify below)
2 PVC	4 ABS	6 Asbestos-Cement	8 Concrete Tile	_____

Blank casing diameter 5.5 in. Was casing pulled? Yes _____ No
 Casing height above or below land surface 3ft below ground. If yes, how much _____

6 GROUT PLUG MATERIAL: 1 Neat cement 2 Cement grout 3 Bentonite 4 Other Clay Soil

Grout Plug Intervals: From 19' 6" ft. to 2' ft., From 2' ft. to 0' ft., From _____ to _____ ft.

What is the nearest source of possible contamination: 3

<input checked="" type="radio"/> 1 Septic tank	6 Seepage pit	11 Fuel Storage	16 Other (specify below)
2 Sewer lines	7 Pit privy	12 Fertilizer storage	_____
3 Watertight sewer lines	8 Sewage lagoon	13 Insecticide storage	_____
4 Lateral lines	9 Feedyard	14 Abandoned water well	Direction from well? <u>South</u>
5 Cess pool	10 Livestock pens	15 Oil well/Gas well	How many feet? <u>100'</u>

FROM	TO	PLUGGING MATERIALS	FROM	TO	PLUGGING MATERIALS
		<u>Old Pump Removed</u>			
		<u>Chlorinated Water</u>			
		<u>used well Gravel from 86' ft to 19' 6"</u>			
		<u>Bentonite from 19' 6" to 2'</u>			
		<u>Clay soil from 2' to surface</u>			

7 CONTRACTOR'S OR LANDOWNER'S CERTIFICATION: This water well was plugged under my jurisdiction and was completed on (mo/day/year) 8/13/15 and this record is true to the best of my knowledge and belief. Kansas Water Well Contractor's License No. 732. This Water Well Record was completed on (mo/day/year) 8/13/15 under the business name of GB Environmental by (signature) James Bieker

INSTRUCTIONS: Use typewriter or ballpoint pen. Please press firmly and print clearly. Please fill in blanks, underline or circle the correct answers. Send top three copies to Kansas Department of Health and Environment, Bureau of Water, Geology Section, 1000 SW Jackson St., Ste. 420, Topeka, Kansas 66612-1367. Telephone: 785/296-5522. Send one to Water Well Owner and retain one for your records. Visit us at <http://www.kdheks.gov/geo/waterwells>.