

WATER WELL PLUGGING RECORD

Form WWC-5P

KSA 82a-1212

ID NO.

MW13

1 LOCATION OF WATER WELL:
County: Linn

Fraction
¼ NW ¼ NE ¼ SW ¼

Section Number
31

Township Number
T 21 S

Range Number
25 [X] E [] W

Street/Rural Address of Well Location: if unknown, distance & direction from nearest town or intersection: If at owner's address, check here []

~60' S of 1012 Main St., Pleasanton, KS


Global Positioning Systems (GPS) information:
Latitude: NA (in decimal degrees)
Longitude: NA (in decimal degrees)
Elevation: NA

Horizontal Datum [] WGS84, [] NAD83, [] NAD27
Collection Method:

2 WATER WELL OWNER:
RR#, St. Address, Box #: Enlow Sales Co. PO Box 1546
City, State ZIP Code: Manhattan, KS 66502

[] GPS unit (Make/model: _____)
[] Digital Map/Photo, [] Topographic Map, [] Land Survey

Est. Accuracy: [] <3 m, [] 3-5 m, [] 5-15 m, [] >15 m

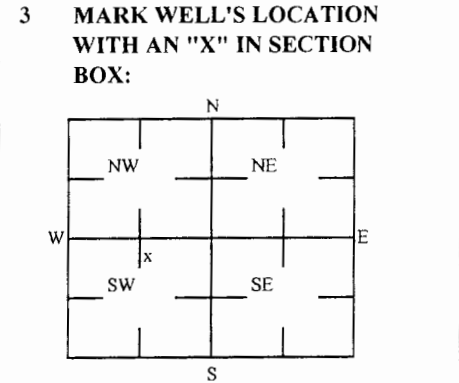

4 DEPTH OF WELL 20.2 ft. MW13
WELL'S STATIC WATER LEVEL NA ft
WELL WAS USED AS:
[] Domestic [] Public Water Supply [] Dewatering
[] Irrigation [] Oil Field Water Supply [X] Monitoring
[] Feedlot [] Domestic (Lawn & Garden) [] Injection Well
[] Industrial [] Air Conditioning [] Other _____
Was a chemical/bacteriological sample submitted to Department? Yes [] No [X]

5 TYPE OF BLANK CASING USED:
[] Steel [] RMP (SR) [] Wrought [] Fiberglass [] Other (Specific below)
[X] PVC [] ABS [] Asbestos-Cement [] Concrete Tile _____
Blank casing diameter 2 in. Was casing pulled? Yes [X] No [] If yes, how much 3'
Casing height above or below land surface NA in.

6 GROUT PLUG MATERIAL: [] Neat cement [] Cement grout [X] Bentonite [X] Other Soil 0-3'
Grout Plug Intervals: From 3 ft to 20.2 ft, From _____ ft to _____ ft, From _____ ft to _____ ft.
What is the nearest source of possible contamination:
[] Septic tank [] Seepage pit [] Fuel storage [] Other (specify below) _____
[] Sewer lines [] Pit privy [] Fertilizer storage _____
[] Watertight sewer lines [] Sewage lagoon [] Insecticide storage _____
[] Lateral lines [] Feed yard [] Abandoned water well Direction from well? _____
[] Cess pool [] Livestock pens [] Oil well/Gas well How many feet? _____

FROM	TO	PLUGGING MATERIALS	FROM	TO	PLUGGING MATERIALS
0	3	Soil			
3	20.2	Bentonite			

KDHE ID: Mangold's Market Basket; U3-054-14623

7 CONTRACTOR'S OR LANDOWNER'S CERTIFICATION: This water well was plugged under my jurisdiction and was completed on (mo/day/year) 8/22/2017 and this record is true to the best of my knowledge and belief. Kansas Water Contractor's License No. 757. This Water Well Record was completed on (mo/day/year) 8/22/2017 under the business name of Larsen & Associates, Inc. By (signature) _____

Send one white copy to Kansas Department of Health & Environment, Geology Section, 1000 SW Jackson Street, Ste. 420, Topeka, KS 66612-1367. Send one copy to WATER WELL OWNER and retain one for your records. Visit us at <http://www.kdheks.gov/waterwell/index.html> Telephone 785-296-5524.