

WATER WELL PLUGGING RECORD Form WWC-5P

KSA 82a-1212

ID NO.

GW-35

1 LOCATION OF WATER WELL: Fraction $\frac{1}{4}$ NE $\frac{1}{4}$ SW $\frac{1}{4}$ NE $\frac{1}{4}$ Section Number 35 Township Number T 21 S Range Number 25 ☒ E ☐ W

Street/Rural Address of Well Location; if unknown, distance & direction from nearest town or intersection: If at owner's address, check here ☐ Approx 5 miles East on Tiger Road from Pleasanton, KS (RAPP (ARNOLD) Property)

Global Positioning Systems (GPS) information:

Latitude: N 38° 10' 43.4" (in decimal degrees)

Longitude: W-094° 37' 36.5" (in decimal degrees)

Elevation: ± 860.8


Horizontal Datum: ☐ WGS84, ☒ NAD83, ☐ NAD27

Collection Method:

2 WATER WELL OWNER: Continental Coal Inc
RR#, St. Address, Box #: 10801 MASTIN, Suite 920
City, State ZIP Code: Overland Park, KS 66210

☒ GPS unit (Make/Model: GARMIN 172☐ Digital Map/Photo, ☐ Topographic Map, ☐ Land SurveyEst. Accuracy: ☐ < 3 m, ☐ 3-5 m, ☒ 5-15 m, ☐ > 15 m

3 MARK WELL'S LOCATION WITH AN "X" IN SECTION BOX:

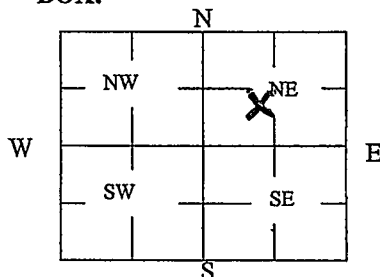

4 DEPTH OF WELL 82.5 ft.

WELL'S STATIC WATER LEVEL 36.0 ft

WELL WAS USED AS:

☐
☐
☐
☐

Domestic
Irrigation
Feedlot
Industrial

☐
☐
☐
☐

Public Water Supply
Oil Field Water Supply
Domestic (Lawn & Garden)
Air Conditioning

☒
☒
☐
☐

Dewatering
Monitoring
Injection Well
Other

Was a chemical/bacteriological sample submitted to Department? Yes ☐ No ☒

5 TYPE OF BLANK CASING USED:

☐ Steel
☒ PVC

☐ RMP (SR)
☐ ABS

☐ Wrought
☐ Asbestos-Cement

☐ Fiberglass
☐ Concrete Tile
☐ Other (Specify below)

Blank casing diameter 2 in. Was casing pulled? Yes ☒ No ☐ If yes, how much 48"
Casing height above or below land surface 48 in.

6 GROUT PLUG MATERIAL: ☒ Neat cement ☐ Cement grout ☐ Bentonite ☐ Other

Grout Plug Intervals: From 82.5 ft. to 4.0 ft., From 4.0 ft. to 3.0 ft., From _____ ft. to _____ ft.

Concrete

What is the nearest source of possible contamination:

☒ Septic tank
☐ Sewer lines
☐ Watertight sewer lines
☐ Lateral lines
☐ Cess pool

☐ Seepage pit
☐ Pit privy
☐ Sewage lagoon
☐ Feedyard
☐ Livestock pens

☐ Fuel storage
☐ Fertilizer storage
☐ Insecticide storage
☐ Abandoned water well
☐ Oil well/Gas well
☐ Other (specify below)

Direction from well? South
How many feet? 3000 FT

FROM	TO	PLUGGING MATERIALS	FROM	TO	PLUGGING MATERIALS
82.5	4.0	Neat Cement			
4.0	3.0	Concrete			
3.0	0.0	Compacted Soil			

7 CONTRACTOR'S OR LANDOWNER'S CERTIFICATION: This water well was plugged under my jurisdiction and was completed on (mo/day/year) 11-23-2021 and this record is true to the best of my knowledge and belief. Kansas Water Well Contractor's License No. N/A. This Water Well Record was completed on (mo/day/year) 11-24-2021 under the business name of Continental Coal Inc (well owner) (signature) Philip E. Teaney

Send one white copy to Kansas Department of Health & Environment, Geology Section, 1000 SW Jackson Street, Ste. 420, Topeka, KS 66612-1367. Send one copy to WATER WELL OWNER and retain one for your records.

Visit us at <http://www.kdheks.gov/waterwell/index.html> Telephone 785-296-5524.