


1 LOCATION OF WATER WELL: County: Marion Fraction NE 1/4 NW 1/4 NE 1/4 Section Number 13 Township Number T 21 S Range Number R 3 EW

Distance and direction from nearest town or city street address of well if located within city? 4 mile North 2 3/4 East of Peabody

2 WATER WELL OWNER: Carl Peterson Rtl Peabody, Ks 66866 Board of Agriculture, Division of Water Resources Application Number:

3 LOCATE WELL'S LOCATION WITH AN "X" IN SECTION BOX:

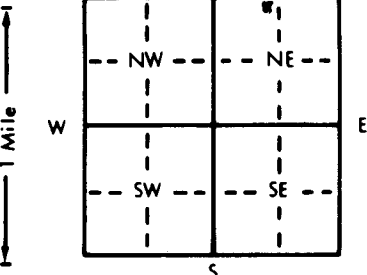

4 DEPTH OF COMPLETED WELL: 40 ft. ELEVATION: Depth(s) Groundwater Encountered 1. Re-Const. ft. 2. WELL'S STATIC WATER LEVEL 15 ft. below land surface measured on mo/day/yr Jan 13 93

5 TYPE OF BLANK CASING USED: 1 Steel 2 PVC 3 RMP (SR) 4 ABS 5 Wrought iron 6 Asbestos-Cement 7 Fiberglass 8 Concrete tile 9 Other (specify below) CASING JOINTS: Glued X Clamped Welded Threaded

TYPE OF SCREEN OR PERFORATION MATERIAL: 1 Steel 2 Brass 3 Stainless steel 4 Galvanized steel 5 Fiberglass 6 Concrete tile 7 PVC 8 RMP (SR) 9 ABS 10 Asbestos-cement 11 Other (specify) 12 None used (open hole)

SCREEN OR PERFORATION OPENINGS ARE: 1 Continuous slot 2 Louvered shutter 3 Mill slot 4 Key punched 5 Gauzed wrapped 6 Wire wrapped 7 Torch cut 8 Saw cut 9 Drilled holes 11 None (open hole) 10 Other (specify)

SCREEN-PERFORATED INTERVALS: From 30 ft. to 48 ft. GRAVEL PACK INTERVALS: From NONE ft. to

6 GROUT MATERIAL: 1 Neat cement 2 Cement grout 3 Bentonite 4 Other Grout intervals: From 0 ft. to 24 ft.

What is the nearest source of possible contamination: 1 Septic tank 2 Sewer lines 3 Watertight sewer lines 4 Lateral lines 5 Cess pool 6 Seepage pit 7 Pit privy 8 Sewage lagoon 9 Feedyard 10 Livestock pens 11 Fuel storage 12 Fertilizer storage 13 Insecticide storage 14 Abandoned water well 15 Oil well/Gas well 16 Other (specify below)

Table with columns: FROM, TO, LITHOLOGIC LOG (Reconstructed Well), FROM, TO, PLUGGING INTERVALS (No Log)

7 CONTRACTOR'S OR LANDOWNER'S CERTIFICATION: This water well was (2) reconstructed, or (3) plugged under my jurisdiction and was completed on Jan 13 93 and this record is true to the best of my knowledge and belief. Kansas Water Well Contractor's License No. 218 This Water Well Record was completed on Feb 2 93 under the business name of Zinn Water Well Dring by signature Joseph A. Zinn

INSTRUCTIONS: Use typewriter or ball point pen. PLEASE PRESS FIRMLY and PRINT clearly. Please fill in blanks, underline or circle the correct answers. Send top three copies to Kansas Department of Health and Environment, Bureau of Water, Topeka, Kansas 66620-0001. Telephone: 913-296-5545. Send one to WATER WELL OWNER and retain one for your records.