


1 LOCATION OF WATER WELL: Fraction SE 1/4 NW 1/4 SE 1/4 Section Number 25 Township Number T 21 S Range Number R 3 EW
 County: Marion

Distance and direction from nearest town or city street address of well if located within city? 2 3/4 East of 1 1/4 North of East Edge of Peabody (Squared off)

2 WATER WELL OWNER: Carl Petersen
 RR#, St. Address, Box #: Rt 1 Board of Agriculture, Division of Water Resources
 City, State, ZIP Code: Marion, Ks 66861 Application Number:

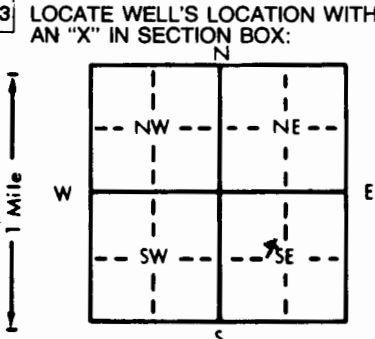

4 DEPTH OF COMPLETED WELL: 49 ft. ELEVATION:
 Depth(s) Groundwater Encountered 1. * ft. 2. ft. 3. ft.
 WELL'S STATIC WATER LEVEL: 18 ft. below land surface measured on mo/day/yr Oct 10 88
 Pump test data: Well water was ft. after hours pumping gpm
 Est. Yield 7 gpm: Well water was ft. after hours pumping gpm
 Bore Hole Diameter: 8 in. to * ft., and in. to ft.
 WELL WATER TO BE USED AS:
 Domestic 3 Feedlot 6 Oil field water supply 9 Dewatering 12 Other (Specify below)
 2 Irrigation 4 Industrial 7 Lawn and garden only 10 Monitoring well
 Was a chemical/bacteriological sample submitted to Department? Yes.....No λ.....; If yes, mo/day/yr sample was submitted
 Water Well Disinfected? Yes No

5 TYPE OF BLANK CASING USED:
 1 Steel 3 RMP (SR) 5 Wrought iron 8 Concrete tile CASING JOINTS: Glued X Clamped
 PVC 4 ABS 6 Asbestos-Cement 9 Other (specify below) Welded
 7 Fiberglass Threaded
 Blank casing diameter 5 in. to 18 ft., Dia in. to ft., Dia in. to ft.
 Casing height above land surface: 16 in., weight lbs./ft. Wall thickness or gauge No. SDR 26
 TYPE OF SCREEN OR PERFORATION MATERIAL:
 PVC 10 Asbestos-cement
 1 Steel 3 Stainless steel 5 Fiberglass 8 RMP (SR) 11 Other (specify)
 2 Brass 4 Galvanized steel 6 Concrete tile 9 ABS 12 None used (open hole)
 SCREEN OR PERFORATION OPENINGS ARE:
 5 Gauzed wrapped Saw cut 11 None (open hole)
 1 Continuous slot 3 Mill slot 6 Wire wrapped 9 Drilled holes
 2 Louvered shutter 4 Key punched 7 Torch cut 10 Other (specify)
 SCREEN-PERFORATED INTERVALS: From 18 ft. to 49 ft., From ft. to ft.
 From ft. to ft., From ft. to ft.
 GRAVEL PACK INTERVALS: From NONE ft. to ft., From ft. to ft.
 From ft. to ft., From ft. to ft.

6 GROUT MATERIAL: Neat cement 2 Cement grout 3 Bentonite 4 Other
 Grout Intervals: From 0 ft. to 18 ft., From ft. to ft., From ft. to ft.
 What is the nearest source of possible contamination:
 1 Septic tank 4 Lateral lines 7 Pit privy 10 Livestock pens 14 Abandoned water well
 2 Sewer lines 5 Cess pool 8 Sewage lagoon 11 Fuel storage 15 Oil well/Gas well
 3 Watertight sewer lines 6 Seepage pit 9 Feedyard 12 Fertilizer storage 16 Other (specify below) Pasture
 13 Insecticide storage
 Direction from well? Well in Pasture How many feet? within

FROM	TO	LITHOLOGIC LOG	FROM	TO	PLUGGING INTERVALS
		<u>* Well was re-constructed</u>			
		<u>No Log</u>			
		<u>#2</u>			

7 CONTRACTOR'S OR LANDOWNER'S CERTIFICATION: This water well was (1) constructed, reconstructed, or (3) plugged under my jurisdiction and was completed on (mo/day/year) Oct 10 88 and this record is true to the best of my knowledge and belief. Kansas Water Well Contractor's License No. 210 This Water Well Record was completed on (mo/day/yr) Jun 2 88 under the business name of Zinn Water Well Drig by (signature) Joseph A. Zinn

INSTRUCTIONS: Use typewriter or ball point pen. PLEASE PRESS FIRMLY and PRINT clearly. Please fill in blanks, underline or circle the correct answers. Send top three copies to Kansas Department of Health and Environment, Bureau of Water Protection, Topeka, Kansas 66620-7320. Telephone: 913-296-5514. Send one to WATER WELL OWNER and retain one for your records.

OFFICE USE ONLY
T
R
EW
SEC
1/2
1/2
1/2