


1 LOCATION OF WATER WELL: Fraction NE 1/4 SE 1/4 NW 1/4 Section Number 35 Township Number T 21 S Range Number R 3 E  
 County: Marion

Distance and direction from nearest town or city street address of well if located within city?  
1/2 mile East & 1/2 mile North of east edge of Peabody (squared off)

2 WATER WELL OWNER: Carl Peterson  
 RR#, St. Address, Box #: Rt 1 Board of Agriculture, Division of Water Resources  
 City, State, ZIP Code: Marion Ks 66861 Application Number:

3 LOCATE WELL'S LOCATION WITH AN "X" IN SECTION BOX:

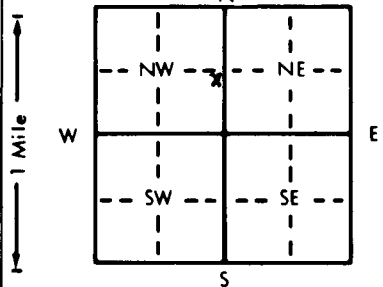

4 DEPTH OF COMPLETED WELL: 60 ft. ELEVATION:  
 Depth(s) Groundwater Encountered 1. X ft. 2. ft. 3. ft.  
 WELL'S STATIC WATER LEVEL: 21 ft. below land surface measured on mo/day/yr Oct 17 88  
 Pump test data: Well water was ft. after hours pumping gpm  
 Est. Yield: 20 gpm Well water was ft. after hours pumping gpm  
 Bore Hole Diameter: 8 in. to X ft., and in. to ft.  
 WELL WATER TO BE USED AS:  
 Domestic 3 Feedlot 6 Oil field water supply 9 Dewatering 12 Other (Specify below)  
 2 Irrigation 4 Industrial 7 Lawn and garden only 10 Monitoring well  
 Was a chemical/bacteriological sample submitted to Department? Yes No X If yes, mo/day/yr sample was submitted  
 Water Well Disinfected? Yes No

5 TYPE OF BLANK CASING USED:  
 1 Steel 3 RMP (SR) 5 Wrought iron 8 Concrete tile CASING JOINTS: Glued X Clamped  
 PVC 4 ABS 7 Fiberglass 9 Other (specify below) Welded  
 Blank casing diameter: 5 in. to 21 ft., Dia. in. to ft., Dia. in. to ft.  
 Casing height above land surface: 16 in., weight lbs./ft. Wall thickness or gauge No. SDR 26  
 TYPE OF SCREEN OR PERFORATION MATERIAL:  
 PVC 10 Asbestos-cement  
 1 Steel 3 Stainless steel 5 Fiberglass 8 RMP (SR) 11 Other (specify)  
 2 Brass 4 Galvanized steel 6 Concrete tile 9 ABS 12 None used (open hole)  
 SCREEN OR PERFORATION OPENINGS ARE:  
 5 Gauzed wrapped  Saw cut 11 None (open hole)  
 1 Continuous slot 3 Mill slot 6 Wire wrapped 9 Drilled holes  
 2 Louvered shutter 4 Key punched 7 Torch cut 10 Other (specify)  
 SCREEN-PERFORATED INTERVALS: From 21 ft. to 60 ft., From ft. to ft.  
 From ft. to ft., From ft. to ft.  
 GRAVEL PACK INTERVALS: From NONE ft. to ft., From ft. to ft.  
 From ft. to ft., From ft. to ft.

6 GROUT MATERIAL:  Neat cement 2 Cement grout 3 Bentonite 4 Other  
 Grout Intervals: From 0 ft. to 20 ft., From ft. to ft., From ft. to ft.  
 What is the nearest source of possible contamination:  
 1 Septic tank 4 Lateral lines 7 Pit privy 10 Livestock pens 14 Abandoned water well  
 2 Sewer lines 5 Cess pool 8 Sewage lagoon 11 Fuel storage 15 Oil well/Gas well  
 3 Watertight sewer lines 6 Seepage pit 9 Feedyard 12 Fertilizer storage 16 Other (specify below)  
13 Insecticide storage Pasture  
 Direction from well? Well in Pasture How many feet? within

FROM	TO	LITHOLOGIC LOG	FROM	TO	PLUGGING INTERVALS
		<u>* Well was re-constructed</u>			
		<u>No Log</u>			
		<u># 7</u>			

7 CONTRACTOR'S OR LANDOWNER'S CERTIFICATION: This water well was (1) constructed,  reconstructed, or (3) plugged under my jurisdiction and was completed on (mo/day/year) Oct 17 88 and this record is true to the best of my knowledge and belief. Kansas  
 Water Well Contractor's License No. 218 This Water Well Record was completed on (mo/day/yr) Jun 2 89  
 under the business name of ZINN Water Well Drlg by (signature) Joseph A. Zinn