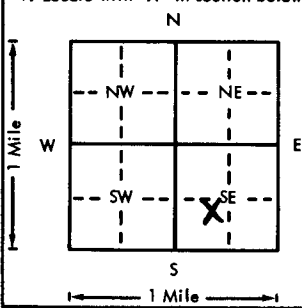


USE TYPEWRITER OR BALL POINT PEN—PRESS FIRMLY, PRINT CLEARLY.

WATER WELL RECORD
KSA 82a-1201-1215

Kansas Department of Health and Environment—Division of Environment
(Water well Contractors)
Topeka, Kansas 66620

1. Location of well:	County Marion	Fraction NE 1/4 SW 1/4 SE 1/4	Section number 4	Township number T 21 S R 4 E/W	Range number
2. Distance and direction from nearest town or city: 7 S 2 E Marion			3. Owner of well: Hallett Construction Co. R.R. or street: Box 26 City, state, zip code: Crosby Minnesota 56441		
4. Locate with "X" in section below: 			Sketch map:		
5. Type and color of material			From	To	6. Bore hole dia. <u>11</u> in. Completion date <u>2-18-76</u> Well depth <u>80</u> ft.
Limestone			0	12	7. <input checked="" type="checkbox"/> Cable tool <input type="checkbox"/> Rotary <input type="checkbox"/> Driven <input type="checkbox"/> Dug <input type="checkbox"/> Hollow rod <input type="checkbox"/> Jetted <input type="checkbox"/> Bored <input type="checkbox"/> Reverse rotary
Yellow Shale			12	35	8. Use: <input type="checkbox"/> Domestic <input type="checkbox"/> Public supply <input checked="" type="checkbox"/> Industry <input type="checkbox"/> Irrigation <input type="checkbox"/> Air conditioning <input type="checkbox"/> Stock <input type="checkbox"/> Lawn <input type="checkbox"/> Oil field water <input checked="" type="checkbox"/> Other
Red Shale			35	52	9. Casing: Material <u>PVC</u> Height: Above or below <u>24</u> in. Threaded <input type="checkbox"/> Welded <input type="checkbox"/> Surface <u>24</u> in. RMP <u>8</u> PVC <input checked="" type="checkbox"/> Class <u>200</u> Weight <u>200</u> lbs./ft. Dia. <u>8</u> in. to <u>80</u> ft. depth Wall thickness <u>inches</u> or Dia. <u>in.</u> to <u>ft.</u> depth gage No. <u>035</u>
Limestone			52	66	10. Screen: Manufacturer's name <u>Certain-Teed</u> Type <u>PVC</u> Dia. <u>8 in.</u> Slot/gauze <u>1/8</u> Length <u>30</u> Set between <u>50</u> ft. and <u>80</u> ft. Gravel pack? <input checked="" type="checkbox"/> Size range of material <u>3/8</u> ft.
Water			66	67	11. Static water level: <u>52</u> ft. below land surface Date <u>2-18-76</u> mo./day/yr.
Gray Rock			67	75	12. Pumping level below land surfaces: _____ ft. after _____ hrs. pumping _____ g.p.m. _____ ft. after _____ hrs. pumping _____ g.p.m. Estimated maximum yield _____ g.p.m.
Water			75	76	13. Water sample submitted: _____ mo./day/yr. Yes <input checked="" type="checkbox"/> No <input type="checkbox"/> Date _____
Gray Shale			76	80	14. Well head completion: <input type="checkbox"/> Pitless adapter <u>24</u> inches above grade
(Use a second sheet if needed)					15. Well grouted? <input checked="" type="checkbox"/> With: <input type="checkbox"/> Neap cement <input type="checkbox"/> Bentonite <input checked="" type="checkbox"/> Concrete Depth: From <u>5</u> ft. to <u>15</u> ft.
18. Elevation:			19. Remarks: This well is for washing rock at rock quarry Well has 4 ft. x 8ft. x2ft. concrete slab		16. Nearest source of possible contamination: _____ ft. _____ Direction _____ type _____ Well disinfected upon completion? <input checked="" type="checkbox"/> Yes <input type="checkbox"/> No
Topography: <input type="checkbox"/> Hill <input checked="" type="checkbox"/> Slope <input type="checkbox"/> Upland <input type="checkbox"/> Valley			20. Water well contractor's certification: This well was drilled under my jurisdiction and this report is true to the best of my knowledge and belief. Backhaus Drilling 180 Business name _____ License No. _____ Address Tampa, Kansas Signed <u>Paul Backhaus</u> Authorized representative <u>2-20-76</u>		

Forward the white, blue and pink copies to the Department of Health and Environment

Form WWC-5

21
 4
 W
 4
 NE SUSE
 1/4 1/4 1/4