USE TYPEWRITER OR BALL POINT PEN-PRESS FIRMLY, PRINT CLEARLY.

WATER WELL RECORD
KSA 82a-1201-1215

Kansas Department of Health and Environment-Division of Environment
(Water well Contractors)
Topeka, Kansas 66620

1. Location of well:	County	Fraction	Section number	Township number	Range number
	Marion	NW 1/4 NW 1/4 NE 1/4	11	T 20 S	R 4 (E) W

2. Distance and direction from nearest town or city: ½ N 1½ W
Street address of well location if in city: Florence

3. Owner of well: Mrs Elizabeth Padtett
R.R. or street: RR1
City, state, zip code: Florence Ks.

4. Locate with "X" in section below:

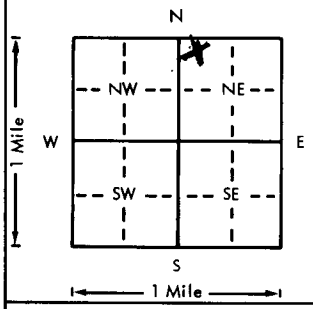

Sketch map:

6. Bore hole dia. ___ in. Completion date 8-17-77
Well depth 103 ft.

7. X Cable tool __ Rotary __ Driven __ Dug
__ Hollow rod __ Jetted __ Bored __ Reverse rotary

8. Use: X Domestic __ Public supply __ Industry
__ Irrigation __ Air conditioning __ Stock
__ Lawn __ Oil field water __ Other

9. Casing: Material PVC Height: Above or below
Threaded ___ Welded ___ Surface 13 in.
RMP ___ PVC X Weight Sch 40 lbs./ft.
Dia. 5 in. to 103 ft. depth Wall Thickness: inches or
Dia. ___ in. to ___ ft. depth gage No. 250

10. Screen: Manufacturer's name ASTM
Type PVC Dia. 5"
Slot/gauze 40 Length 25
Set between 50 ft. and 60 ft.
88 ft. and 103 ft.
Gravel pack? X Size range of material 4-8

11. Static water level: mo./day/yr.
40 ft. below land surface Date 8-17-77

12. Pumping level below land surfaces:
___ ft. after ___ hrs. pumping ___ g.p.m.
___ ft. after ___ hrs. pumping ___ g.p.m.
Estimated maximum yield ___ g.p.m.

13. Water sample submitted: mo./day/yr.
__ Yes X No Date ___

14. Well head completion:
X Pitless adapter ___ Inches above grade

15. Well grouted? X
With: X Neat cement ___ Bentonite ___ Concrete
Depth: From 3 ft. to 13 ft.

16. Nearest source of possible contamination: Barn
ft. 200 Direction SE Type yard
Well disinfected upon completion? X Yes ___ No

17. Pump: X Not installed
Manufacturer's name ___
Model number ___ HP ___ Volts ___
Length of drop pipe ___ ft. capacity ___ g.p.m.
Type:
__ Submersible __ Turbine
__ Jet __ Reciprocating
__ Centrifugal __ Other

5. Type and color of material	From	To
Top Soil	0	2
Red Clay	2	9
Lime Stone	9	55
Some Water	55	56
Gray Rock	56	92
Water	92	94
Gray Rock	94	103

(Use a second sheet if needed)

18. Elevation:
Topography:
X Hill
__ Slope
__ Upland
__ Valley

19. Remarks: Owner to run Concrete Slab around Well 4'x4'x4"

20. Water well contractor's certification:
This well was drilled under my jurisdiction and this report is true to the best of my knowledge and belief.
Business name Baekhus Drgl. 180 License No.
Address Tampa Ks.
Signed [signature] Date ___
Authorized representative

T 20 R 4 (E) W Sec 11 1/4 1/4 1/4 NW NW NE

Forward the white, blue and pink copies to the Department of Health and Environment

Form WWC-5

MI-1023