


1 LOCATION OF WATER WELL: County: Manos Fraction: SE 1/4 SW 1/4 SW 1/4 Section Number: 6 Township Number: T 21 S Range Number: R 5 E/W

Distance and direction from nearest town or city street address of well if located within city?
IN TOWN OF FLORENCE

2 WATER WELL OWNER: MARK Austin
RR#, St. Address, Box #: 109 W 833 412 W9th Board of Agriculture, Division of Water Resources
City, State, ZIP Code: Florence KS Application Number:

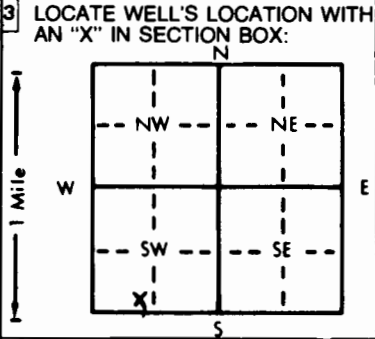

4 DEPTH OF COMPLETED WELL: 40 ft. ELEVATION: _____
Depth(s) Groundwater Encountered 1. 12 ft. 2. _____ ft. 3. _____ ft.
WELL'S STATIC WATER LEVEL: 11 ft. below land surface measured on Jul 21 01
Pump test data: Well water was _____ ft. after _____ hours pumping _____ gpm
Est. Yield 20+ gpm: Well water was _____ ft. after _____ hours pumping _____ gpm
Bore Hole Diameter: 8 5/8 in. to 27 ft. and 7 in. to 40 ft.
WELL WATER TO BE USED AS:
1 Domestic (circled) 3 Feedlot 5 Public water supply 8 Air conditioning 11 Injection well
2 Irrigation 4 Industrial 6 Oil field water supply 9 Dewatering 12 Other (Specify below)
7 Lawn and garden only 10 Monitoring well
Was a chemical/bacteriological sample submitted to Department? Yes _____ No _____ If yes, mo/day/yr sample was submitted _____
Water Well Disinfected? Yes _____ No _____

5 TYPE OF BLANK CASING USED:
1 Steel (circled) 3 RMP (SR) 5 Wrought iron 8 Concrete tile CASING JOINTS: Glued X Clamped _____
2 PVC (circled) 4 ABS 6 Asbestos-Cement 9 Other (specify below) Welded _____
7 Fiberglass Threaded _____
Blank casing diameter: 5 in. to 12 ft. Dia. _____ in. to _____ ft. Dia. _____ in. to _____ ft.
Casing height above land surface: 18 in., weight _____ lbs./ft. Wall thickness or gauge No. SDR-26
TYPE OF SCREEN OR PERFORATION MATERIAL:
1 Steel 3 Stainless steel 5 Fiberglass 8 RMP (SR) 10 Asbestos-cement
2 Brass 4 Galvanized steel 6 Concrete tile 9 ABS 11 Other (specify) _____
12 None used (open hole)
SCREEN OR PERFORATION OPENINGS ARE:
1 Continuous slot 3 Mill slot 5 Gauzed wrapped 8 Saw cut (circled) 11 None (open hole)
2 Louvered shutter 4 Key punched 6 Wire wrapped 9 Drilled holes
7 Torch cut 10 Other (specify) _____
SCREEN-PERFORATED INTERVALS: From 12 ft. to 40 ft. From _____ ft. to _____ ft.
GRAVEL PACK INTERVALS: From 11 ft. to 40 ft. From _____ ft. to _____ ft.

6 GROUT MATERIAL: 1 Neat cement (circled) 2 Cement grout 3 Bentonite 4 Other _____
Grout Intervals: From 3 ft. to 11 ft. From _____ ft. to _____ ft. From _____ ft. to _____ ft.
What is the nearest source of possible contamination:
1 Septic tank 4 Lateral lines 7 Pit privy 10 Livestock pens 14 Abandoned water well
2 Sewer lines 5 Cess pool 8 Sewage lagoon 11 Fuel storage 15 Oil well/Gas well
3 Watertight sewer lines (circled) 6 Seepage pit 9 Feedyard 12 Fertilizer storage 16 Other (specify below)
13 Insecticide storage
Direction from well? East How many feet? 100'

FROM	TO	LITHOLOGIC LOG	FROM	TO	PLUGGING INTERVALS
0	3	Top Soil			
3	12	Red Clay (SANDY Texture)			
12	18	Gravel & Sandy			
18	23	Shale Gray			
23	27	LIME TAN			
27	30	Shale Blue Green			
30	34	LIME TAN			
34	40	Red Shale			

7 CONTRACTOR'S OR LANDOWNER'S CERTIFICATION: This water well was (1) constructed, (2) reconstructed, or (3) plugged under my jurisdiction and was completed on (mo/day/year) Jul 21 01 and this record is true to the best of my knowledge and belief. Kansas Water Well Contractor's License No. 218 This Water Well Record was completed on (mo/day/yr) Aug 4 01 under the business name of Zinn Water Well Dnls by (signature) Joseph A. Zinn

INSTRUCTIONS: Use typewriter or ball point pen. PLEASE PRESS FIRMLY and PRINT clearly. Please fill in blanks, underline or circle the correct answers. Send top three copies to Kansas Department of Health and Environment, Bureau of Water, Topeka, Kansas 66620-0001. Telephone: 913-296-5545. Send one to WATER WELL OWNER and retain one for your records.

OFFICE USE ONLY
T
R
EW
SEC.
1/4
1/4
1/4