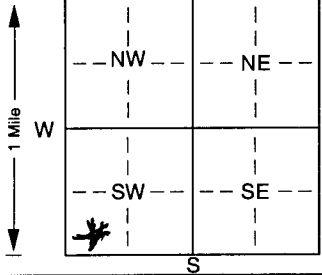


1 LOCATION OF WATER WELL: Fraction SW 1/4 SW 1/4 SW 1/4 Section Number 3 Township Number T 21 S Range Number R 50 EA
 County: Morton

Distance and direction from nearest town or city street address of well if located within city?
2 1/2 E Florence

2 WATER WELL OWNER: Leslie Lalouette
 RR#, St. Address, Box #: RH Board of Agriculture, Division of Water Resources
 City, State, ZIP Code: Florence, Ks, 66851 Application Number:

3 LOCATE WELL'S LOCATION WITH AN "X" IN SECTION BOX:  4 DEPTH OF COMPLETED WELL: 58 ft. ELEVATION: ft.
 Depth(s) Groundwater Encountered: 1. 4.6 ft. 2. ft. 3. ft.
 WELL'S STATIC WATER LEVEL: 33 ft. below land surface measured on mo/day/yr 1-25-02
 Pump test data: Well water was ft. after hours pumping gpm
 Est. Yield 2.0 gpm: Well water was ft. after hours pumping gpm
 Bore Hole Diameter: 2 1/2 in. to 5 1/2 ft., and in. to ft.
 WELL WATER TO BE USED AS: 5 Public water supply 8 Air conditioning 11 Injection well
1 Domestic 3 Feedlot 6 Oil field water supply 9 Dewatering 12 Other (Specify below)
2 Irrigation 4 Industrial 7 Domestic (lawn & garden) 10 Monitoring well
 Was a chemical/bacteriological sample submitted to Department? Yes. No. X; If yes, mo/day/yr sample was sub-
 mitted Water Well Disinfected? Yes X No

5 TYPE OF BLANK CASING USED: 5 Wrought iron 8 Concrete tile CASING JOINTS: Glued X Clamped.
 1 Steel 3 RMP (SR) 6 Asbestos-Cement 9 Other (specify below) Welded
 2 PVC 4 ABS 7 Fiberglass Threaded
 Blank casing diameter: 5 in. to 3 1/2 ft., Dia in. to ft., Dia in. to ft.
 Casing height above land surface: 24 in., weight 12.5/160 lbs./ft. Wall thickness or gauge No. 2/14
 TYPE OF SCREEN OR PERFORATION MATERIAL: 7 PVC 10 Asbestos-cement
 1 Steel 3 Stainless steel 5 Fiberglass 8 RMP (SR) 11 Other (specify)
 2 Brass 4 Galvanized steel 6 Concrete tile 9 ABS 12 None used (open hole)
 SCREEN OR PERFORATION OPENINGS ARE: 5 Gauzed wrapped 8 Saw cut 11 None (open hole)
 1 Continuous slot 3 Mill slot 6 Wire wrapped 9 Drilled holes
 2 Louvered shutter 4 Key punched 7 Torch cut 10 Other (specify) ft.
 SCREEN-PERFORATED INTERVALS: From 3 1/2 ft. to 5 1/2 ft., From ft. to ft.
 From ft. to ft., From ft. to ft.
 GRAVEL PACK INTERVALS: From 20 ft. to 5 1/2 ft., From ft. to ft.
 From ft. to ft., From ft. to ft.

6 GROUT MATERIAL: 1 Neat cement 2 Cement grout 3 Bentonite 4 Other
 Grout Intervals: From 0 ft. to 20 ft., From ft. to ft., From ft. to ft.
 What is the nearest source of possible contamination:
 1 Septic tank 4 Lateral lines 7 Pit privy 10 Livestock pens 14 Abandoned water well
 2 Sewer lines 5 Cess pool 8 Sewage lagoon 11 Fuel storage 15 Oil well/Gas well
 3 Watertight sewer lines 6 Seepage pit 9 Feedyard 12 Fertilizer storage 16 Other (specify below)
 13 Insecticide storage
 Direction from well? SW How many feet? 100 +

FROM	TO	LITHOLOGIC LOG	FROM	TO	PLUGGING INTERVALS
0	2	Clay			
2	3 1/2	lime + mixed shale			
3 1/2	4 1/2	Blue Shale			
4 1/2	4 8	lime			
4 8	4 9	Water - Gravel			
4 9	5 1/2	lime			
5 1/2	5 8	Gray Rock			

7 CONTRACTOR'S OR LANDOWNER'S CERTIFICATION: This water well was (1) constructed, (2) reconstructed, or (3) plugged under my jurisdiction and was completed on (mo/day/year) 1-25-02 and this record is true to the best of my knowledge and belief. Kansas Water Well Contractor's Licence No. 100 This Water Well Record was completed on (mo/day/yr) 1-26-02 under the business name of Backhus Drilling by (signature) Paul Backhus