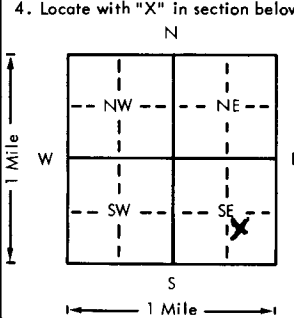


USE TYPEWRITER OR BALL POINT PEN—PRESS FIRMLY, PRINT CLEARLY.

WATER WELL RECORD
KSA 82a-1201-1215

Kansas Department of Health and Environment—Division of Environment
(Water well Contractors)
Topeka, Kansas 66620

1. Location of well: County Marion Fraction NW 1/4 SE 1/4 SE 1/4 Section number 6 Township number T 21 S R 5 E Range number 5 E	
2. Distance and direction from nearest town or city: 1/2 East 1/4 North Street address of well location if in city: Florence 3. Owner of well: Sunflower Crushed Stone Inc R.R. or street: RR-1 Po Bx 125 City, state, zip code: Florence Kansas 66851	
4. Locate with "X" in section below: Sketch map: 	
5. Type and color of material	
	From To
Top Soil & waste Rock.	0 10
Shale Gray some Calc Lens.	10 20
Shale Red. (Dense)	20 28
Soft Lime Gray	28 29
Hard Gray Lime (water)	29 34
Shale Gray - Green.	34 44
Hard Gray Lime.	44 46
Shale with silt stone lens.	46 58
Water produces from seam & crack in lime. TD	58
Two tests approx 150' NE produced salt & high mineral water from 130' down to 190' these were cemented & filled to surface (tests were approx 50' higher elevation.) <small>(Use a second sheet if needed)</small>	
18. Elevation: Topography: <input type="checkbox"/> Hill <input type="checkbox"/> Slope <input checked="" type="checkbox"/> Upland <input checked="" type="checkbox"/> Valley	19. Remarks: Well located on top of high bank east of river does not flood. Drilled in the weathered rock back from the river about 100'
6. Bore hole dia. 10 in. Completion date 5/4/78 Well depth 58 ft.	
7. <input checked="" type="checkbox"/> Cable tool <input type="checkbox"/> Rotary <input type="checkbox"/> Driven <input type="checkbox"/> Dug <input type="checkbox"/> Hollow rod <input type="checkbox"/> Jetted <input type="checkbox"/> Bored <input type="checkbox"/> Reverse rotary	
8. Use: <input checked="" type="checkbox"/> Domestic <input type="checkbox"/> Public supply <input type="checkbox"/> Industry <input type="checkbox"/> Irrigation <input type="checkbox"/> Air conditioning <input type="checkbox"/> Stock <input type="checkbox"/> Lawn <input type="checkbox"/> Oil field water <input type="checkbox"/> Other	
9. Casing: Material <input type="checkbox"/> Height: Above or below surface 2.5 Ft. Threading <input type="checkbox"/> Welded <input type="checkbox"/> Surface 2.5 Ft. RMP <input type="checkbox"/> PVC <input checked="" type="checkbox"/> Weight <input type="checkbox"/> lbs./ft. Dia. 8 in. to 58 ft. depth Wall thickness: inches or Dia. <input type="checkbox"/> in. to <input type="checkbox"/> ft. depth gage No. 3/8"	
10. Screen: Manufacturer's name Shop Type Sew slot Dia. 8 Slot 1/16 x 9/16 Length 54 ft. Set between 22 ft. and 54 ft. Gravel pack? No Size range of material <input type="checkbox"/>	
11. Static water level: 25 ft. below land surface Date 5/4/1978 mo./day/yr.	
12. Pumping level below land surfaces: <input type="checkbox"/> ft. after <input type="checkbox"/> hrs. pumping <input type="checkbox"/> g.p.m. <input type="checkbox"/> ft. after <input type="checkbox"/> hrs. pumping <input type="checkbox"/> g.p.m. Estimated maximum yield 4-5 g.p.m.	
13. Water sample submitted: <input type="checkbox"/> Yes <input checked="" type="checkbox"/> No Date <input type="checkbox"/>	
14. Well head completion: <input type="checkbox"/> Pitless adapter 30 inches above grade	
15. Well grouted? <input checked="" type="checkbox"/> With <input checked="" type="checkbox"/> Neat cement <input type="checkbox"/> Bentonite <input type="checkbox"/> Concrete Depth: From 0 ft. to 14 ft.	
16. Nearest source of possible contamination: 100' Direction WEST Type River Well disinfected upon completion? <input checked="" type="checkbox"/> Yes <input type="checkbox"/> No	
17. Pump: <input checked="" type="checkbox"/> Not installed Manufacturer's name <input type="checkbox"/> Model number <input type="checkbox"/> HP <input type="checkbox"/> Volts <input type="checkbox"/> Length of drop pipe <input type="checkbox"/> ft. capacity <input type="checkbox"/> g.p.m. Type: <input type="checkbox"/> Submersible <input type="checkbox"/> Turbine <input type="checkbox"/> Jet <input type="checkbox"/> Reciprocating <input type="checkbox"/> Centrifugal <input type="checkbox"/> Other	

Forward the white, blue and pink copies to the Department of Health and Environment

Form WWC-5