


1 LOCATION OF WATER WELL: Fraction SE 1/4 NW 1/4 NE 1/4 Section Number 11 Township Number T 21 S Range Number R 7 EN  
 County: Chase  
 Distance and direction from nearest town or city street address of well if located within city?  
4 1/2 West of 2 1/2 South of BAZZAR

2 WATER WELL OWNER: Fred Lyons Jr.  
 RR#, St. Address, Box #: 2720 Verona Circle  
 City, State, ZIP Code: Shawnee Mission, KS 66208  
 Board of Agriculture, Division of Water Resources  
 Application Number:

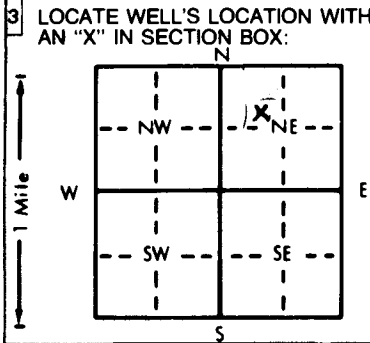

4 DEPTH OF COMPLETED WELL: 21 ft. ELEVATION:  
 Depth(s) Groundwater Encountered 1. 9 ft. 2. ft. 3. ft.  
 WELL'S STATIC WATER LEVEL 6 ft. below land surface measured on mo/day/yr JAN 26 97  
 Pump test data: Well water was ft. after hours pumping gpm  
 Est. Yield 2.5 gpm: Well water was ft. after hours pumping gpm  
 Bore Hole Diameter 48 in. to 12 in. and 12 in. to 21 in.  
 WELL WATER TO BE USED AS: 5 Public water supply 8 Air conditioning 11 Injection well  
 1 Domestic 3 Feedlot 6 Oil field water supply 9 Dewatering 12 Other (Specify below)  
 2 Irrigation 4 Industrial 7 Lawn and garden only 10 Monitoring well  
 Was a chemical/bacteriological sample submitted to Department? Yes.....No X..... If yes, mo/day/yr sample was submitted  
 Water Well Disinfected? Yes X No

5 TYPE OF BLANK CASING USED:  
 1 Steel 3 RMP (SR) 5 Wrought iron 8 Concrete tile CASING JOINTS: Glued X Clamped  
 2 PVC 4 ABS 7 Fiberglass 9 Other (specify below) Welded  
 Blank casing diameter 13 1/2 in. to 10 ft., Dia. in. to ft., Dia. in. to ft.  
 Casing height above land surface 24 in., weight lbs./ft. Wall thickness or gauge No. Sch 40  
 TYPE OF SCREEN OR PERFORATION MATERIAL:  
 1 Steel 3 Stainless steel 5 Fiberglass 8 RMP (SR) 10 Asbestos-cement  
 2 Brass 4 Galvanized steel 6 Concrete tile 9 ABS 11 Other (specify)  
 SCREEN OR PERFORATION OPENINGS ARE:  
 5 Gauzed wrapped 8 Saw cut 11 None (open hole)  
 1 Continuous slot 3 Mill slot 6 Wire wrapped 9 Drilled holes  
 2 Louvered shutter 4 Key punched 7 Torch cut 10 Other (specify)  
 SCREEN-PERFORATED INTERVALS: From 10 ft. to 21 ft., From ft. to ft.  
 GRAVEL PACK INTERVALS: From 7 ft. to 21 ft., From ft. to ft.

6 GROUT MATERIAL:  1 Neat cement 2 Cement grout 3 Bentonite 4 Other  
 Grout Intervals: From 3 ft. to 7 ft., From ft. to ft., From ft. to ft.  
 What is the nearest source of possible contamination:  
 1 Septic tank 4 Lateral lines 7 Pit privy 10 Livestock pens 14 Abandoned water well  
 2 Sewer lines 5 Cess pool 8 Sewage lagoon 11 Fuel storage 15 Oil well/Gas well  
 3 Watertight sewer lines 6 Seepage pit 9 Feedyard 12 Fertilizer storage 16 Other (specify below) Stream  
 Direction from well? NE How many feet? 100'

FROM	TO	LITHOLOGIC LOG	FROM	TO	PLUGGING INTERVALS
0	5	Top soil Bk			
5	8	Clay Red Silty			
8	9	Gravel in Red Clay			
9	11	Gravel			
11	21	LIME STONE			

7 CONTRACTOR'S OR LANDOWNER'S CERTIFICATION: This water well was (1) constructed, (2) reconstructed, or (3) plugged under my jurisdiction and was completed on (mo/day/year) JAN 26 97 and this record is true to the best of my knowledge and belief. Kansas Water Well Contractor's License No. 210 This Water Well Record was completed on (mo/day/yr) Feb 5 97 under the business name of Zinn Water Well Dng by (signature) Joseph A. Zinn

INSTRUCTIONS: Use typewriter or ball point pen. PLEASE PRESS FIRMLY and PRINT clearly. Please fill in blanks, underline or circle the correct answers. Send top three copies to Kansas Department of Health and Environment, Bureau of Water, Topeka, Kansas 66620-0001. Telephone: 913-296-5545. Send one to WATER WELL OWNER and retain one for your records.

OFFICE USE ONLY T R EW SEC. 1/4 1/4 1/4