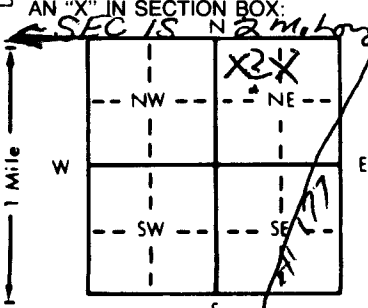


1 LOCATION OF WATER WELL: County: **CHASE** Fraction: **NW 1/4 NE 1/4 NE 1/4** Section Number: **7** Township Number: **T 21 S** Range Number: **R 8 EW**

Distance and direction from nearest town or city street address of well if located within city?


5.5 M N OF MAT FIELD GREEN

2 WATER WELL OWNER: **BERNIE BECKMAN WICHITA, KS**
 RR#, St. Address, Box #: **11417 W. PONDEROSA 67212**
 City, State, ZIP Code: **WICHITA, KS 67212**
 Board of Agriculture, Division of Water Resources
 Application Number:

3 LOCATE WELL'S LOCATION WITH AN "X" IN SECTION BOX:

 4 DEPTH OF COMPLETED WELL: **51** ft. ELEVATION:
 Depth(s) Groundwater Encountered 1. **12** ft. 2. **31** ft. 3. **31** ft.
 WELL'S STATIC WATER LEVEL **23** ft. below land surface measured on mo/day/yr
 BAIL Pump test data: Well water was _____ ft. after _____ hours pumping _____ gpm
 Est. Yield **2** gpm: Well water was _____ ft. after _____ hours pumping _____ gpm
 Bore Hole Diameter: **7.5** in. to **51** ft., and _____ in. to _____ ft.
 WELL WATER TO BE USED AS:
 1 Domestic 2 Irrigation 3 Feedlot 4 Industrial 5 Public water supply 6 Oil field water supply 7 Lawn and garden only 8 Air conditioning 9 Dewatering 10 Monitoring well 11 Injection well 12 Other (Specify below)
 Was a chemical/bacteriological sample submitted to Department? Yes _____ No **X**; If yes, mo/day/yr sample was submitted _____
 Water Well Disinfected? Yes **X** No

5 TYPE OF BLANK CASING USED:
 1 Steel 2 PVC 3 RMP (SR) 4 ABS 5 Wrought iron 6 Asbestos-Cement 7 Fiberglass 8 Concrete tile 9 Other (specify below) CASING JOINTS: Glued **X** Clamped _____ Welded _____ Threaded _____
 Blank casing diameter **4.5** in. to _____ ft., Dia. _____ in. to _____ ft., Dia. _____ in. to _____ ft.
 Casing height above land surface: **26** in., weight **SCH 40** lbs./ft. Wall thickness or gauge No. _____
 TYPE OF SCREEN OR PERFORATION MATERIAL:
 1 Steel 2 Brass 3 Stainless steel 4 Galvanized steel 5 Fiberglass 6 Concrete tile 7 PVC 8 RMP (SR) 9 ABS 10 Asbestos-cement 11 Other (specify) 12 None used (open hole)
 SCREEN OR PERFORATION OPENINGS ARE:
 1 Continuous slot 2 Louvered shutter 3 Mill slot 4 Key punched 5 Gauzed wrapped 6 Wire wrapped 7 Torch cut 8 Saw cut 9 Drilled holes 10 Other (specify) 11 None (open hole)
 SCREEN-PERFORATED INTERVALS: From **25** ft. to **35** ft., From **43** ft. to **50** ft.
 GRAVEL PACK INTERVALS: From **20** ft. to **51** ft.

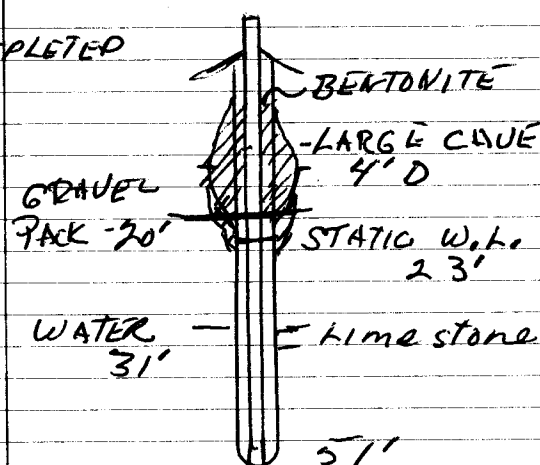6 GROUT MATERIAL: 1 Neat cement 2 Cement grout 3 Bentonite 4 Other
 Grout Intervals: From **0** ft. to **20** ft., From _____ ft. to _____ ft., From _____ ft. to _____ ft.
 What is the nearest source of possible contamination:
 1 Septic tank 2 Sewer lines 3 Watertight sewer lines 4 Lateral lines 5 Cess pool 6 Seepage pit 7 Pit privy 8 Sewage lagoon 9 Feedyard 10 Livestock pens 11 Fuel storage 12 Fertilizer storage 13 Insecticide storage 14 Abandoned water well 15 Oil well/Gas well 16 Other (specify below)
LARGE GRASS AREA
 Direction from well? How many feet?

FROM	TO	LITHOLOGIC LOG	FROM	TO	PLUGGING INTERVALS
0	5	TOP SILT			
5	20	CLAY SILT - WATER-CAUSED - THEN DEPLETED			
20	21	LIME			
21	31	SHALE			
31	32	LIME			
32	40	LT.G. SHALE			
40	51	DK. B. SHALE			
					

7 CONTRACTOR'S OR LANDOWNER'S CERTIFICATION: This water well was (1) constructed, (2) reconstructed, or (3) plugged under my jurisdiction and was completed on (mo/day/year) **12-04-98** and this record is true to the best of my knowledge and belief. Kansas Water Well Contractor's License No. **479** This Water Well Record was completed on (mo/day/yr) **12-31-98** under the business name of **EBBERTS DRILLING** by (signature) *Walter J. Ebberts*