

County: Chase Fraction: SW, NW, NE, SE Sec. 18 T. 21 S R. 8 E

**CORRECTION(S) to WATER WELL COMPLETION RECORD Form WWC-5** (to rectify lacking or incorrect information)

Owner: Ks Dept of Transportation Hand-dug well

If location corrected, was listed as:

Section-Township-Range: \_\_\_\_\_

Location changed to:

Fraction (1/4 calls): NE, SW

SW, NW, NE, SE

Other changes: Initial statements: Horizontal Datum not reported. Casing not 'pulled.' Top of rock casing was 4-in above ground before plugged. Business name not provided.

Changed to: WGS84 (Google Maps used), 1-2 feet rock casing removed, so TOC 1-2 feet below land after plugging. Now 21-ft below new slope for K-177 project. Well plugged by King's Construction Co.

Comments: Well plugged same day as plugging record completed - 19 Nov 2021

Verification method: Information provided and/or confirmed by Jeremy George, with King's Construction.

Also used KDHE STR Finder and Google Earth.

Initials: PKC Date: 11/29/2021

Submitted by:  Kansas Geological Survey, Data Resources Library, 1930 Constant Ave., Lawrence, KS 66047-3724


Kansas Dept. of Health & Environment, Bureau of Water, 1000 SW Jackson, Suite 420, Topeka, KS 66612-1367

**WATER WELL PLUGGING RECORD Form WWC-5P**

KSA 82a-1212 ID NO.  

**1 LOCATION OF WATER WELL:** Fraction NE 1/4 SW 1/4 Section Number 18 Township Number T 21 S Range Number 8  E  W  
 County: Chase  
 Street/Rural Address of Well Location; if unknown, distance & direction from nearest town or intersection: If at owner's address, check here  Approx 4.27 miles North on K177 From intersection K-177 & Brandley Ave in Matfield Green, Ks. Then 150 ft. West  
**Global Positioning Systems (GPS) information:**  
 Latitude: 38.2221517 (in decimal degrees)  
 Longitude: -96.5679383 (in decimal degrees)  
 Elevation: \_\_\_\_\_  
 Horizontal Datum:  WGS84,  NAD83,  NAD27  
 Collection Method: \_\_\_\_\_

**2 WATER WELL OWNER:** KDOT  
 RR#, St. Address, Box #: \_\_\_\_\_  
 City, State ZIP Code: \_\_\_\_\_  
 GPS unit (Make/Model: Google Maps - Cellphone)  
 Digital Map/Photo,  Topographic Map,  Land Survey  
 Est. Accuracy:  < 3 m,  3-5 m,  5-15 m,  > 15 m

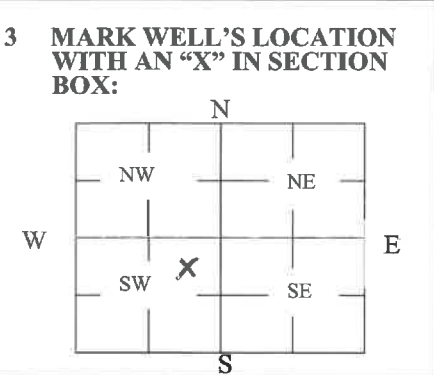

**4 DEPTH OF WELL** 31 ft.  
 WELL'S STATIC WATER LEVEL 15 ft.  
 WELL WAS USED AS:  
 Domestic  Public Water Supply  Dewatering  
 Irrigation  Oil Field Water Supply  Monitoring  
 Feedlot  Domestic (Lawn & Garden)  Injection Well  
 Industrial  Air Conditioning  Other unknown  
 Was a chemical/bacteriological sample submitted to Department? Yes  No

**5 TYPE OF BLANK CASING USED:**  
 Steel  RMP (SR)  Wrought  Fiberglass  Other (Specify below)  
 PVC  ABS  Asbestos-Cement  Concrete Tile hand laid stone (Rock)  
 Blank casing diameter 40 in. Was casing pulled? Yes  No  If yes, how much \_\_\_\_\_  
 Casing height above or below land surface 4 in.

**6 GROUT PLUG MATERIAL:**  Neat cement  Cement grout  Bentonite  Other \_\_\_\_\_  
 Grout Plug Intervals: From 5 ft. to 4 1/2 ft., From \_\_\_\_\_ ft. to \_\_\_\_\_ ft., From \_\_\_\_\_ ft. to \_\_\_\_\_ ft.  
 What is the nearest source of possible contamination:  
 Septic tank  Seepage pit  Fuel storage  Other (specify below)  
 Sewer lines  Pit privy  Fertilizer storage Nickel Creek  
 Watertight sewer lines  Sewage lagoon  Insecticide storage \_\_\_\_\_  
 Lateral lines  Feedyard  Abandoned water well \_\_\_\_\_  
 Cess pool  Livestock pens  Oil well/Gas well \_\_\_\_\_  
 Direction from well? South  
 How many feet? 1050

FROM	TO	PLUGGING MATERIALS	FROM	TO	PLUGGING MATERIALS
31'	15'	gravel & sand			
15'	5'	clay			
5'	4 1/2'	cement			
4 1/2'	0'	CLAY			
0	-22'	CLAY	NEW K177	SLOPE COVERS	EXIST. PLUGGED WELL

**7 CONTRACTOR'S OR LANDOWNER'S CERTIFICATION:** This water well was plugged under my jurisdiction and was completed on (mo/day/year) \_\_\_\_\_ and this record is true to the best of my knowledge and belief. Kansas Water Well Contractor's License No. \_\_\_\_\_. This Water Well Record was completed on (mo/day/year) 11-19-21 under the business name of \_\_\_\_\_ by (signature) [Signature]

Send one white copy to Kansas Department of Health & Environment, Geology Section, 1000 SW Jackson Street, Ste. 420, Topeka, KS 66612-1367. Send one copy to WATER WELL OWNER and retain one for your records.  
 Visit us at <http://www.kdheks.gov/waterwell/index.html> Telephone 785-296-5524.