


1 LOCATION OF WATER WELL: Fraction NW 1/4 NW 1/4 NW 1/4 Section Number 30 Township Number T 21 S Range Number R 8 EW
 County: CHASE

Distance and direction from nearest town or city street address of well if located within city?
3 M-N IF MATFIELD GREEN - HWY - 177

2 WATER WELL OWNER: MARK CRDFOOT
 RR#, St. Address, Box #: RR 1 MATFIELD GREEN KS 66862 Board of Agriculture, Division of Water Resources
 City, State, ZIP Code: Application Number:

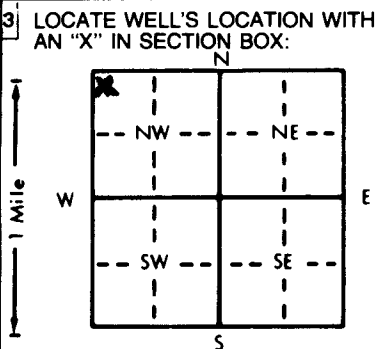

4 DEPTH OF COMPLETED WELL: 36-6L ft. ELEVATION:
 Depth(s) Groundwater Encountered * ft. 2. ft. 3. ft.
 WELL'S STATIC WATER LEVEL 18 ft. below land surface measured on mo/day/yr 02-12-91
 Pump test data: Well water was ft. after hours pumping gpm
 Est. Yield 8.9 gpm: Well water was ft. after .5 hours pumping 8.9 gpm
 Bore Hole Diameter * 8 7/8 in. to 36 ft., and in. to ft.
 WELL WATER TO BE USED AS:
 1 Domestic 3 Feedlot 6 Oil field water supply 9 Dewatering 12 Other (Specify below)
 2 Irrigation 4 Industrial 7 Lawn and garden only 10 Monitoring well
 Was a chemical/bacteriological sample submitted to Department? Yes No X; If yes, mo/day/yr sample was submitted
 Water Well Disinfected? Yes X No

5 TYPE OF BLANK CASING USED:
 1 Steel 3 RMP (SR) 5 Wrought iron 8 Concrete tile CASING JOINTS: Glued X Clamped
 2 PVC 4 ABS 6 Asbestos-Cement 9 Other (specify below) Welded
 7 Fiberglass Threaded
 Blank casing diameter 6 in. to 35 ft., Dia. in. to ft., Dia. in. to ft.
 Casing height above land surface * 36 in., weight 200 lbs./ft. Wall thickness or gauge No.
 TYPE OF SCREEN OR PERFORATION MATERIAL:
 1 Steel 3 Stainless steel 5 Fiberglass 7 PVC 10 Asbestos-cement
 2 Brass 4 Galvanized steel 6 Concrete tile 8 RMP (SR) 11 Other (specify)
 9 ABS 12 None used (open hole)
 SCREEN OR PERFORATION OPENINGS ARE:
 1 Continuous slot 3 Mill slot 5 Gauzed wrapped 8 Saw cut 11 None (open hole)
 2 Louvered shutter 4 Key punched 6 Wire wrapped 9 Drilled holes
 7 Torch cut 10 Other (specify)
 SCREEN-PERFORATED INTERVALS: From 25 ft. to 36 ft., From ft. to ft.
 From ft. to ft., From ft. to ft.
 GRAVEL PACK INTERVALS: From 15 ft. to 36 ft., From ft. to ft.
 From ft. to ft., From ft. to ft.

6 GROUT MATERIAL: 1 Neat cement 2 Cement grout 3 Bentonite 4 Other
 Grout Intervals: From 4 ft. to 15 ft., From ft. to ft., From ft. to ft.
 What is the nearest source of possible contamination:
 1 Septic tank 4 Lateral lines 7 Pit privy 10 Livestock pens 14 Abandoned water well
 2 Sewer lines 5 Cess pool 8 Sewage lagoon 11 Fuel storage 15 Oil well/Gas well
 3 Watertight sewer lines 6 Seepage pit 9 Feedyard 12 Fertilizer storage 16 Other (specify below)
 13 Insecticide storage
 Direction from well? 1-NE 10 E 14 SE How many feet? 1-100 10-200 14-120

LITHOLOGIC LOG FROM TO PLUGGING INTERVALS

* NO HISTORY - RECORDS - KNOWN TO BE OVER 40 YEARS OLD - REMOVED 19' OF STEEL 8" ID CASING WHICH WAS PERFORATED FROM 15' TO 17' THIS STEEL CASING WAS SET 3' BELOW 6L THIS WOULD INDICATE THAT THE GROUND WATER WAS FOUND SOME WHERE BETWEEN 16' AND 21'-6L OPEN HOLE BELOW STEEL CASING -

POSSIBLE CONTAMINATIONS ARE ALL DOWN SLOPE FROM WELL

7 CONTRACTOR'S OR LANDOWNER'S CERTIFICATION: This water well was (1) constructed, (2) reconstructed, or (3) plugged under my jurisdiction and was completed on (mo/day/year) 02-13-91 and this record is true to the best of my knowledge and belief. Kansas Water Well Contractor's License No. 479 This Water Well Record was completed on (mo/day/yr) 02-14-91 under the business name of EBBERTS DRILLING by (signature)

OFFICE USE ONLY
T
R
EW
SEC.
1/4
1/4
1/4