


1 LOCATION OF WATER WELL: County: Chase Fraction: NW 1/4 NW 1/4 SE 1/4 Section Number: 26 Township Number: T 21 S Range Number: R 9 E

Distance and direction from nearest town or city street address of well if located within city? 9 1/2 EAST + 2 1/2 N. of Matfield Green  
~~7 East 5 North East of Matfield Green~~ This direction is squared off because of the winding roads.

2 WATER WELL OWNER: Bill Haw  
 RR#, St. Address, Box #: 4800 Main  
 City, State, ZIP Code: Kansas City Missouri  
 Board of Agriculture, Division of Water Resources  
 Application Number:

3 LOCATE WELL'S LOCATION WITH AN "X" IN SECTION BOX:

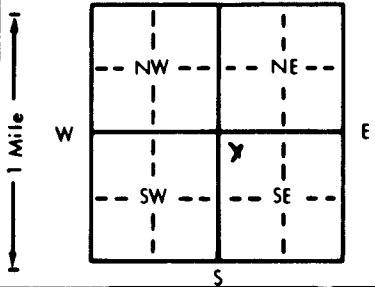

4 DEPTH OF COMPLETED WELL: 111 ft. ELEVATION:

Depth(s) Groundwater Encountered 1. 41 ft. 2. . ft. 3. . ft.  
 WELL'S STATIC WATER LEVEL: 33.5 ft. below land surface measured on mo/day/yr Dec 22 87  
 Pump test data: Well water was . ft. after . hours pumping . gpm  
 Est. Yield: 1.5 gpm: Well water was . ft. after . hours pumping . gpm  
 Bore Hole Diameter: 15 in. to 30 ft., and 12 in. to 111 ft.  
 WELL WATER TO BE USED AS:  
 Domestic  Feedlot  Oil field water supply  Dewatering  Other (Specify below)  
 Irrigation  Industrial  Lawn and garden only  Monitoring well  
 Was a chemical/bacteriological sample submitted to Department? Yes. . No:  . If yes, mo/day/yr sample was submitted .  
 Water Well Disinfected?  Yes No

5 TYPE OF BLANK CASING USED:  
 1 Steel  3 RMP (SR)  6 Asbestos-Cement  9 Other (specify below)  Welded  
 2 PVC  4 ABS  7 Fiberglass  Threaded  
 Blank casing diameter: 10 in. to 30 ft., Dia. . in. to . ft., Dia. . in. to . ft.  
 Casing height above land surface: 16 in., weight . lbs./ft. Wall thickness or gauge No. SDR-26

TYPE OF SCREEN OR PERFORATION MATERIAL:  
 1 Steel  3 Stainless steel  5 Fiberglass  7 PVC  10 Asbestos-cement  
 2 Brass  4 Galvanized steel  6 Concrete tile  9 ABS  11 Other (specify) .  
 12 None used (open hole)

SCREEN OR PERFORATION OPENINGS ARE:  
 1 Continuous slot  3 Mill slot  5 Gauzed wrapped  7 Saw cut  11 None (open hole)  
 2 Louvered shutter  4 Key punched  6 Wire wrapped  9 Drilled holes  
 7 Torch cut  10 Other (specify) .

SCREEN-PERFORATED INTERVALS: From 30 ft. to 111 ft., From . ft. to . ft.  
 GRAVEL PACK INTERVALS: From NONE ft. to . ft., From . ft. to . ft.

6 GROUT MATERIAL:  1 Neat cement  2 Cement grout  3 Bentonite  4 Other .  
 Grout intervals: From 3 ft. to 30 ft., From . ft. to . ft., From . ft. to . ft.

What is the nearest source of possible contamination:  
 1 Septic tank  4 Lateral lines  7 Pit privy  10 Livestock pens  14 Abandoned water well  
 2 Sewer lines  5 Cess pool  8 Sewage lagoon  11 Fuel storage  15 Oil well/Gas well  
 3 Watertight sewer lines  6 Seepage pit  9 Feedyard  12 Fertilizer storage  16 Other (specify below)  
 13 Insecticide storage  
 Direction from well? South West How many feet? 120

FROM	TO	LITHOLOGIC LOG	FROM	TO	PLUGGING INTERVALS
0	2	Top Soil	56	57	Gypsum
2	6	Shale TAN	57	58	Shale Gray
6	12	Shale Green	58	62	LIME Wht.
12	15	Shale Gray	62	69	Sandstone Gray
15	18	LIME Brn	69	90	LIME Gray
18	19	Shale Gray	90	93	Shale Gray
19	23	LIME Brn DK	93	96	LIME DK
23	26	LIME TAN	96	101	Shale DK Black
26	35	Shale DK Gray	101	103	LIME DK TAN with Fuslinds
35	40	LIME Brn	103	111	Shale Black
40	41	Shale Gray			
41	44	LIME Frac lite Gray			
44	49	Shale Blue Green			
49	52	LIME Almost White			
52	56	Shale lite Gray			

7 CONTRACTOR'S OR LANDOWNER'S CERTIFICATION: This water well was  (1) constructed, (2) reconstructed, or (3) plugged under my jurisdiction and was completed on (mo/day/year) Dec 22 87 and this record is true to the best of my knowledge and belief. Kansas Water Well Contractor's License No. 218 This Water Well Record was completed on (mo/day/yr) Dec 30 87 under the business name of ZINN Water Well Dring by (signature) Joseph A. Zinn

INSTRUCTIONS: Use typewriter or ball point pen. PLEASE PRESS FIRMLY and PRINT clearly. Please fill in blanks, underline or circle the correct answers. Send top three copies to Kansas Department of Health and Environment, Bureau of Water Protection, Topeka, Kansas 66620-7320. Telephone: 913-296-5514. Send one to WATER WELL OWNER and retain one for your records.