


1 LOCATION OF WATER WELL: County: Chase Fraction: NE 1/4 NE 1/4 NE 1/4 Section Number: 35 Township Number: T 21 S Range Number: R 9 EW

Distance and direction from nearest town or city street address of well if located within city? 8 East 5 North East of Matfield Green 9 1/8 E + 1 1/8 N of Matfield Green this direction is squared off due to winding roads.

2 WATER WELL OWNER: Bill Haw Board of Agriculture, Division of Water Resources
 RR#, St. Address, Box #: 4800 Main Application Number:
 City, State, ZIP Code: Kansas City Mo

3 LOCATE WELL'S LOCATION WITH AN "X" IN SECTION BOX:

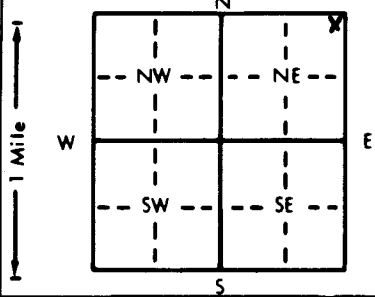

4 DEPTH OF COMPLETED WELL: 40 ft. ELEVATION:
 Depth(s) Groundwater Encountered 1. 18 ft. 2. ft. 3. ft.
 WELL'S STATIC WATER LEVEL: 17 ft. below land surface measured on mo/day/yr Apr 4 88
 Pump test data: Well water was ft. after hours pumping gpm
 Est. Yield 13 gpm: Well water was ft. after hours pumping gpm
 Bore Hole Diameter: 8 in. to 17 ft., and 6 1/2 in. to 40 ft.
 WELL WATER TO BE USED AS:
 Domestic Feedlot Oil field water supply Dewatering Other (Specify below)
 Irrigation Industrial Lawn and garden only Monitoring well
 Was a chemical/bacteriological sample submitted to Department? Yes.....No. If yes, mo/day/yr sample was submitted
 Water Well Disinfected? Yes No

5 TYPE OF BLANK CASING USED:
 1 Steel 3 RMP (SR) 5 Wrought iron 8 Concrete tile CASING JOINTS: Glued Clamped.....
 PVC 4 ABS 6 Asbestos-Cement 9 Other (specify below) Welded.....
 7 Fiberglass Threaded.....
 Blank casing diameter: 5 in. to 18 ft., Dia. in. to ft., Dia. in. to ft.
 Casing height above land surface: 15 in., weight lbs./ft. Wall thickness or gauge No. SDR-26

TYPE OF SCREEN OR PERFORATION MATERIAL:
 1 Steel 3 Stainless steel 5 Fiberglass 8 RMP (SR) 10 Asbestos-cement
 2 Brass 4 Galvanized steel 6 Concrete tile 9 ABS 11 Other (specify).....
 12 None used (open hole)

SCREEN OR PERFORATION OPENINGS ARE:
 1 Continuous slot 3 Mill slot 5 Gauzed wrapped 8 Saw cut 11 None (open hole)
 2 Louvered shutter 4 Key punched 6 Wire wrapped 9 Drilled holes
 7 Torch cut 10 Other (specify).....

SCREEN-PERFORATED INTERVALS: From 18 ft. to 40 ft., From ft. to ft.
 From ft. to ft., From ft. to ft.
 GRAVEL PACK INTERVALS: From 17 ft. to 40 ft., From ft. to ft.
 From ft. to ft., From ft. to ft.

6 GROUT MATERIAL: Neat cement 2 Cement grout 3 Bentonite 4 Other.....
 Grout intervals: From 3 ft. to 17 ft., From ft. to ft., From ft. to ft.

What is the nearest source of possible contamination:
 1 Septic tank 4 Lateral lines 7 Pit privy 10 Livestock pens Abandoned water well
 2 Sewer lines 5 Cess pool 8 Sewage lagoon 11 Fuel storage 15 Oil well/Gas well
 3 Watertight sewer lines 6 Seepage pit 9 Feedyard 12 Fertilizer storage 16 Other (specify below)
 13 Insecticide storage
 Direction from well? West How many feet? 90

FROM	TO	LITHOLOGIC LOG	FROM	TO	PLUGGING INTERVALS
0	1	Topsoil			
1	17	Clay Brn			
17	18	Gravel Fine			
18	23	Gravel Coarse			
23	28	Shale Gray			
28	31	LIME Gray			
31	37	Shale Gray			
37	38	LIME Gray			
38	40	Shale Gray			

7 CONTRACTOR'S OR LANDOWNER'S CERTIFICATION: This water well was constructed, reconstructed, or plugged under my jurisdiction and was completed on (mo/day/year) Apr 4 88 and this record is true to the best of my knowledge and belief. Kansas Water Well Contractor's License No. 218 This Water Well Record was completed on (mo/day/yr) Apr 30 - 88 under the business name of ZINN Water Well Drlg. by (signature) Joseph A. Zinn