

USE TYPEWRITER OR BALL POINT PEN-PRESS FIRMLY, PRINT CLEARLY.


WATER WELL RECORD
KSA 82a-1201-1215

Kansas State Dept. Of Health
(Water Well Contractors)
Forbes-Bldg. 740
Topeka, Kansas 66620

T R EW sec 1/4 1/4 1/4 No.

1 Location of well:	County Harrey Highland	Township name SW SW NW	Fraction	Section number 5	Town number 22-9	Range number 1-E
---------------------	----------------------------------	----------------------------------	----------	----------------------------	----------------------------	----------------------------

Distance and direction from nearest town or city: 3 Mi. East	3 Owner of well: Archie Schmidt
Street address of well location if in city: 1/2 North of Hesston	Address: R.R. 1 Newton Ks.

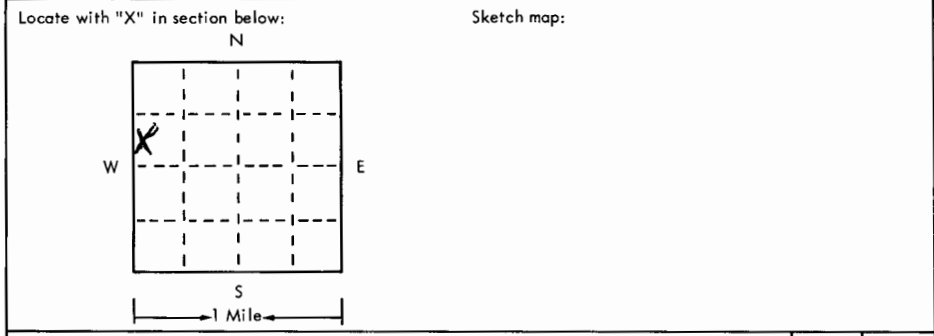

4 Well depth: **54** ft. Date of completion **7-10-25**
Well diameter **9** in.

5 Cable tool Rotary Driven Dug
 Hollow rod Jetted Bored Reverse rotary

6 Use: Domestic Public supply Industry
 Irrigation Air conditioning Commercial
 Test well

7 Casing: Material **PVC** Height: above/below
Threaded Welded Surface **12** in.
Diam. **Glass** Weight **160** lbs./ft.
5 in. to **54** ft. depth Drive shoe? Yes No

2 Type and color of material	From	To
Top Soil	0	5
Yellow Clay	5	25
Sand Gravel	25	45
Blue Shale	45	54

8 Screen: Manufacturer **Certain-teed**
Type **Plastic** Dia. **5 1/4**
Slot/gauze **1/8** Length **10'**
Set between **50** ft. and **50** ft.
Fittings: Gravel pack Yes No Size range of material **3/8**

9 Static water level: **20** ft. below land surface Date **7-10-25**

10 Pumping level below land surfaces:
___ ft. after ___ hrs. pumping ___ g.p.m.
___ ft. after ___ hrs. pumping ___ g.p.m.
Estimated maximum yield ___ g.p.m.

11 Water sample submitted:
 Yes No Date ___

12 Well head completion:
 Pitless adapter Inches above grade

13 Well grouted? Yes No
 Neat cement Bentonite ___
Depth: From **3** ft. to **15** ft.

14 Nearest source of possible contamination: **Barn**
ft. **5** Mi Direction **South** Type **yard**
Well disinfected upon completion? Yes No

15 Pump: Not installed
Manufacturer's name ___
Model number ___ HP ___ Volts ___
Length of drop pipe ___ ft. capacity ___ g.p.m.
Type:
 Submersible Turbine
 Jet Reciprocating
 Centrifugal Other

16 Remarks: elevation

Topography:
 Hill
 Slope
 Upland
 Valley

17 Water well contractor's certification:
This well was drilled under my jurisdiction and this report is true to the best of my knowledge and belief.

Backhus Drilling 180
Business name License No. ___
Address **Jampa, Mo**
Signed **C. Paul Backhus** Date **7-20-25**
Authorized representative