


1 LOCATION OF WATER WELL: Fraction SW 1/4 SE 1/4 SW 1/4 Section Number 5 Township Number T 22 S Range Number R 1-E  
 County: Harvey

Distance and direction from nearest town or city street address of well if located within city?  
6 MILES NORTH OF NEWTON

2 WATER WELL OWNER: Ramona Burkhardt  
 RR#, St. Address, Box #: RR#1, Box 28  
 City, State, ZIP Code: Newton, Kansas 67114  
 Board of Agriculture, Division of Water Resources  
 Application Number:

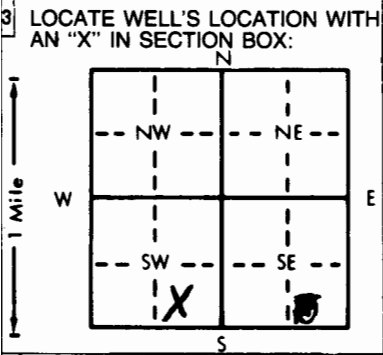

4 DEPTH OF COMPLETED WELL: 62' ft. ELEVATION: HILL  
 Depth(s) Groundwater Encountered 1. 20 ft. 2. . ft. 3. . ft.  
 WELL'S STATIC WATER LEVEL 10 ft. below land surface measured on mo/day/yr 8-16-88  
 Pump test data: Well water was 16 ft. after 1 hours pumping 20 gpm  
 Est. Yield 20 gpm: Well water was . ft. after . hours pumping . gpm  
 Bore Hole Diameter 9" in. to 62 ft., and . in. to . ft.  
 WELL WATER TO BE USED AS:  
 Domestic 3 Feedlot 6 Oil field water supply 9 Dewatering 12 Other (Specify below)  
 2 Irrigation 4 Industrial 7 Lawn and garden only 10 Monitoring well  
 Was a chemical/bacteriological sample submitted to Department? Yes. . No. ; If yes, mo/day/yr sample was submitted  
 Water Well Disinfected?  Yes  No

5 TYPE OF BLANK CASING USED:  
 1 Steel 3 RMP (SR) 5 Wrought iron 8 Concrete tile CASING JOINTS: Glued  Clamped .  
 2 PVC 4 ABS 7 Fiberglass . Welded .  
 Blank casing diameter 5" in. to . ft., Dia. . in. to . ft., Dia. . in. to . ft.  
 Casing height above land surface 30" in., weight 2.29 lbs./ft. Wall thickness or gauge No. 214  
 TYPE OF SCREEN OR PERFORATION MATERIAL:  
 PVC 10 Asbestos-cement  
 1 Steel 3 Stainless steel 5 Fiberglass 8 RMP (SR) 11 Other (specify) .  
 2 Brass 4 Galvanized steel 6 Concrete tile 9 ABS 12 None used (open hole)  
 SCREEN OR PERFORATION OPENINGS ARE:  
 5 Gauzed wrapped  Saw cut 11 None (open hole)  
 1 Continuous slot 3 Mill slot 6 Wire wrapped 9 Drilled holes  
 2 Louvered shutter 4 Key punched 7 Torch cut 10 Other (specify) .  
 SCREEN-PERFORATED INTERVALS: From 20 ft. to 30 ft., From . ft. to . ft.  
 From 52 ft. to 62 ft., From . ft. to . ft.  
 GRAVEL PACK INTERVALS: From 10 ft. to 62 ft., From . ft. to . ft.  
 From . ft. to . ft., From . ft. to . ft.

6 GROUT MATERIAL:  Neat cement 2 Cement grout 3 Bentonite 4 Other .  
 Grout Intervals: From 0 ft. to 10 ft., From 40 ft. to 62 ft., From . ft. to . ft.  
 What is the nearest source of possible contamination:  
 1 Septic tank 4 Lateral lines 7 Pit privy 10 Livestock pens 14 Abandoned water well  
 2 Sewer lines 5 Cess pool 8 Sewage lagoon 11 Fuel storage 15 Oil well/Gas well  
 3 Watertight sewer lines 6 Seepage pit  Feedyard 12 Fertilizer storage 16 Other (specify below)  
 Direction from well? WEST How many feet? 300

FROM	TO	LITHOLOGIC LOG	FROM	TO	PLUGGING INTERVALS
0	8	Clay			
8	15	Fine Sand			
15	25	Coarse Sand			
25	30	Gravel - 3/8"			
30	40	Clay			
40	54	Shale - Blue			
54	56	Shale Brown			
56	62	Shale - Blue			

7 CONTRACTOR'S OR LANDOWNER'S CERTIFICATION: This water well was  constructed, (2) reconstructed, or (3) plugged under my jurisdiction and was completed on (mo/day/year) 8-16-88 and this record is true to the best of my knowledge and belief, Kansas Water Well Contractor's License No. 362 This Water Well Record was completed on (mo/day/yr) 8-19-88 under the business name of Martin Supply by (signature) Buto Schmidt

OFFICE USE ONLY