


1 LOCATION OF WATER WELL: Fraction  $\frac{1}{4}$  S  $\frac{1}{4}$  E  $\frac{1}{4}$  Section Number 9 Township Number T 22 S Range Number R 1 EW

County: *Harvey*  
 Distance and direction from nearest town or city street address of well if located within city?  
*from Newton Mon K15 to Dutch AVE 1/4 M E*

2 WATER WELL OWNER: *Jerol Schmidt*  
 RR#, St. Address, Box #: *R2 Newton Kansas*  
 City, State, ZIP Code: *67053*  
 Board of Agriculture, Division of Water Resources  
 Application Number:

3 LOCATE WELL'S LOCATION WITH AN "X" IN SECTION BOX:  
 4 DEPTH OF COMPLETED WELL: *103* ft. ELEVATION:

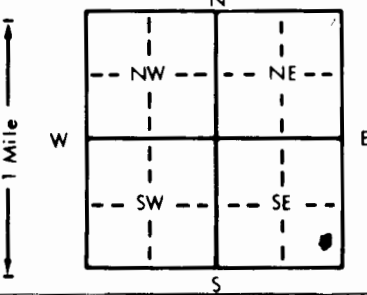

Depth(s) Groundwater Encountered 1 ..... ft. 2 ..... ft. 3 ..... ft.  
 WELL'S STATIC WATER LEVEL *24* ft. below land surface measured on mo/day/yr *Oct 22 1991*  
 Pump test data: Well water was *90* ft. after *2* hours pumping *10* gpm  
 Est. Yield *10* gpm: Well water was ..... ft. after ..... hours pumping ..... gpm  
 Bore Hole Diameter *8* in. to *103* ft., and ..... in. to ..... ft.  
 WELL WATER TO BE USED AS:  
 5 Public water supply 8 Air conditioning 11 Injection well  
 1 Domestic  Feedlot 6 Oil field water supply 9 Dewatering 12 Other (Specify below)  
 2 Irrigation 4 Industrial 7 Lawn and garden only 10 Monitoring well  
 Was a chemical/bacteriological sample submitted to Department? Yes..... No ; If yes, mo/day/yr sample was submitted  
 Water Well Disinfected? Yes  No

5 TYPE OF BLANK CASING USED:  
 1 Steel 3 RMP (SR) 5 Wrought iron 8 Concrete tile CASING JOINTS: Glued ..... Clamped .....  
 PVC 4 ABS 6 Asbestos-Cement 9 Other (specify below) Welded   
 7 Fiberglass Threaded.....

Blank casing diameter *5* in. to *103* ft., Dia ..... in. to ..... ft., Dia ..... in. to ..... ft.  
 Casing height above land surface *18* in., weight ..... lbs./ft. Wall thickness or gauge No. ....

TYPE OF SCREEN OR PERFORATION MATERIAL:  
 1 Steel 3 Stainless steel 5 Fiberglass 8 RMP (SR) 10 Asbestos-cement  
 2 Brass 4 Galvanized steel 6 Concrete tile 9 ABS 11 Other (specify) .....  
 12 None used (open hole)

SCREEN OR PERFORATION OPENINGS ARE:  
 1 Continuous slot 3 Mill slot 5 Gauzed wrapped 8 Saw cut  11 None (open hole)  
 2 Louvered shutter 4 Key punched 6 Wire wrapped 9 Drilled holes  
 7 Torch cut 10 Other (specify) .....

SCREEN-PERFORATED INTERVALS: From *33* ft. to *33* ft., From *83* ft. to *103* ft.  
 From ..... ft. to ..... ft., From ..... ft. to ..... ft.  
 GRAVEL PACK INTERVALS: From *15* ft. to *103* ft., From ..... ft. to ..... ft.  
 From ..... ft. to ..... ft., From ..... ft. to ..... ft.

6 GROUT MATERIAL:  Neat cement 2 Cement grout 3 Bentonite 4 Other .....  
 Grout Intervals: From *top* ft. to *15* ft., From ..... ft. to ..... ft., From ..... ft. to ..... ft.

What is the nearest source of possible contamination:  
 1 Septic tank 4 Lateral lines 7 Pit privy 10 Livestock pens 14 Abandoned water well  
 2 Sewer lines 5 Cess pool 8 Sewage lagoon 11 Fuel storage 15 Oil well/Gas well  
 3 Watertight sewer lines 6 Seepage pit  Feedyard 12 Fertilizer storage 16 Other (specify below)  
 13 Insecticide storage  
 Direction from well? *400 feet E* How many feet?

FROM	TO	LITHOLOGIC LOG	FROM	TO	PLUGGING INTERVALS
4	top	Soil			
4	15	Blue clay			
15	30	limestone rock			
30	55	gravel Blue shale			
55	90	Blue shale			
90	93	Rocky Blue shale			
93	103	Blue shale			

7 CONTRACTOR'S OR LANDOWNER'S CERTIFICATION: This water well was (1) constructed, (2) reconstructed, or (3) plugged under my jurisdiction and was completed on (mo/day/year) *Oct 23 1991* and this record is true to the best of my knowledge and belief. Kansas Water Well Contractor's License No. *221* This Water Well Record was completed on (mo/day/yr) *May 3 1991* under the business name of *Frank Buckel* by (signature) *Frank Buckel*