


This is correct. OK

1 LOCATION OF WATER WELL: Fraction NE NE NE Section Number 12 Township Number T 22 S Range Number R 1 EW  
 County: Harvey  
 Distance and direction from nearest town or city street address of well if located within city? 1 1/2 W 2 N of Walton Kansas.

2 WATER WELL OWNER: Wm R Kasitz  
 RR#, St. Address, Box #: 330 E 10 St Board of Agriculture, Division of Water Resources  
 City, State, ZIP Code: Newton Kans 67114 Application Number:

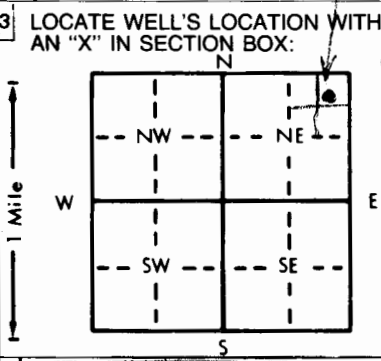

4 DEPTH OF COMPLETED WELL: 98 ft. ELEVATION: ..... ft.  
 Depth(s) Groundwater Encountered: 1. 25 ft. 2. .... ft. 3. .... ft.  
 WELL'S STATIC WATER LEVEL: Top of well ft. below land surface measured on mo/day/yr Sept 6 82  
 Pump test data: Well water was ..... ft. after ..... hours pumping ..... gpm  
 Est. Yield 20 gpm: Well water was 10 ft. after 1 hours pumping ..... gpm  
 Bore Hole Diameter: 12 in. to 98 ft. and ..... in. to ..... ft.  
 (WELL WATER TO BE USED AS):  
 1 Domestic 3 Feedlot 6 Oil field water supply 9 Dewatering 12 Other (Specify below)  
 2 Irrigation 4 Industrial 7 Lawn and garden only 10 Observation well  
 Was a chemical/bacteriological sample submitted to Department? Yes No; If yes, mo/day/yr sample was submitted  
 Water Well Disinfected? Yes No

5 TYPE OF BLANK CASING USED: one of the  
 1 Steel 3 RMP (SR) 7 listed 5 Wrought iron 8 Concrete tile CASING JOINTS: Glued Clamped  
2 PVC 4 ABS 6 Asbestos-Cement 9 Other (specify below) Welded  
 Blank casing diameter 8 in. to 98 ft. Dia ..... in. to ..... ft. Dia ..... in. to ..... ft.  
 Casing height above land surface: 18 in. weight 40 lbs./ft. Wall thickness or gauge No. SDR 26  
 TYPE OF SCREEN OR PERFORATION MATERIAL: gout - PVC  
 1 Steel 3 Stainless steel 5 Fiberglass 8 RMP (SR) 10 Asbestos-cement  
 2 Brass 4 Galvanized steel 6 Concrete tile 9 ABS 11 Other (specify) .....  
 12 None used (open hole)  
 SCREEN OR PERFORATION OPENINGS ARE:  
 1 Continuous slot 3 Mill slot 5 Gauzed wrapped 8 Saw cut 11 None (open hole)  
 2 Louvered shutter 4 Key punched 6 Wire wrapped 9 Drilled holes  
 7 Torch cut 10 Other (specify) .....  
 SCREEN-PERFORATED INTERVALS: From 20 ft. to 40 ft., From 50 ft. to 70 ft.  
 From 80 ft. to 90 ft., From 90 ft. to ..... ft.  
 GRAVEL PACK INTERVALS: From 10 ft. to 98 ft., From ..... ft. to ..... ft.

6 GROUT MATERIAL: Neat cement 2 Cement grout 3 Bentonite 4 Other .....  
 Grout Intervals: From top ft. to 10 ft., From ..... ft. to ..... ft., From ..... ft. to ..... ft.  
 What is the nearest source of possible contamination:  
 1 Septic tank 4 Lateral lines 7 Pit privy 10 Livestock pens 14 Abandoned water well  
 2 Sewer lines 5 Cess pool 8 Sewage lagoon 11 Fuel storage 15 Oil well/Gas well  
 3 Watertight sewer lines 6 Seepage pit 9 Feedyard 12 Fertilizer storage 16 Other (specify below)  
 13 Insecticide storage  
 Direction from well? a little creek south How many feet? 75

FROM	TO	LITHOLOGIC LOG	FROM	TO	LITHOLOGIC LOG
0	2	top soil			
2	30	Blue shale			
30	40	gravel type Blue shale			
40	60	rocky type Blue shale			
60	65	gravel type Blue shale			
65	85	Blue shale			
85	89	lime stone rock.			
89	98	Blue shale			

7 CONTRACTOR'S OR LANDOWNER'S CERTIFICATION: This water well was (1) constructed, (2) reconstructed, or (3) plugged under my jurisdiction and was completed on (mo/day/year) Sept 6 - 82 and this record is true to the best of my knowledge and belief. Kansas Water Well Contractor's License No. 221 This Water Well Record was completed on (mo/day/yr) Mar 16 - 83 under the business name of Frank Budde by (signature) Frank Budde

INSTRUCTIONS: Use typewriter or ball point pen, PLEASE PRESS FIRMLY and PRINT clearly. Please fill in blanks, underline or circle the correct answers. Send top three copies to Kansas Department of Health and Environment, Division of Environment, Environmental Geology Section, Topeka, KS 66620. Send one to WATER WELL OWNER and retain one for your records.

OFFICE USE ONLY  
T  
22  
R  
EW  
SEC  
1E  
NE  
1E

B G