Topeka

USE TYPEWRITER OR BALL POINT PEN-PRESS FIRMLY, PRINT CLEARLY.

**WATER WELL RECORD**
KSA 82a-1201-1215

Kansas Department of Health and Environment-Division of Environment
(Water well Contractors)
Topeka, Kansas 66620

| 1. Location of well: | County | Fraction | Section number | Township number | Range number |
|---|---|---|---|---|---|
| | HARVEY | NW 1/4 NW 1/4 SW 1/4 | 19 | T 22 S | R 1 (E) W |

2. Distance and direction from nearest town or city: 3 E + 1 1/2 S of HESSTON
Street address of well location if in city:

3. Owner of well: Ken Burnham
R.R. or street: RR #1
City, state, zip code: Newton Kns

4. Locate with "X" in section below:

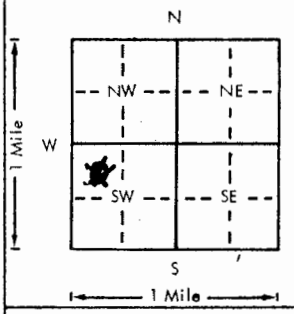


Sketch map:

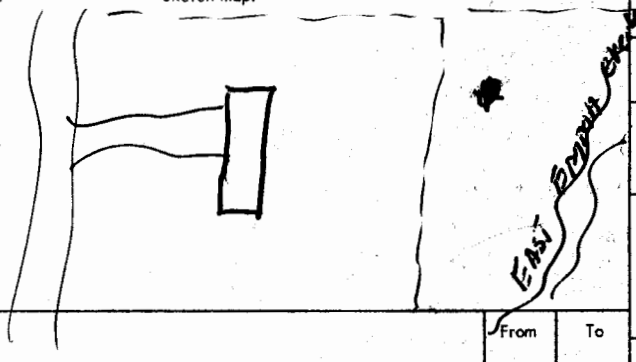


6. Bore hole dia. 12 in. Completion date 5-17-77 + 8-30-77
Well depth ____ ft.

7. __ Cable tool X Rotary __ Driven __ Dug
__ Hollow rod __ Jetted __ Bored __ Reverse rotary

8. Use: X Domestic __ Public supply __ Industry
__ Irrigation __ Air conditioning __ Stock
__ Lawn __ Oil field water __ Other

9. Casing: Material Plastic Height: (Above) or below
Threaded ____ Welded X Surface 24 in.
RMP ____ PVC X Weight ____ lbs./ft.
Dia. 6 in. to 48 ft. depth Wall Thickness: inches or
Dia. ____ in. to ____ ft. depth gage No. #280

10. Screen: Manufacturer's name Robin Tech - Own Slot
Type PVC Dia. 6"
Slot/gauze .046 Length ____
Set between 15 ft. and 35 ft.
____ ft. and ____ ft.
Gravel pack? X Size range of material 1/8-1/4

11. Static water level: mo./day/yr.
3 ft. below land surface Date 8-30-77

12. Pumping level below land surfaces:
48 ft. after 3 hrs. pumping 5 g.p.m.
____ ft. after ____ hrs. pumping ____ g.p.m.
Estimated maximum yield 4-5 g.p.m.

13. Water sample submitted: mo./day/yr.
__ Yes X No Date ____

14. Well head completion:
X Pitless adapter ____ Inches above grade

15. Well grouted? X
With: X Neat cement ____ Bentonite ____ Concrete
Depth: From 10 ft. to 0 ft.

16. Nearest source of possible contamination:
ft. 65 Direction SW Type Sewer
Well disinfected upon completion? X Yes ____ No

17. Pump: ____ Not installed
Manufacturer's name Goulds
Model number ____ HP 1/3 Volts 115
Length of drop pipe 45 ft. capacity 8 g.p.m.
Type:
X Submersible ____ Turbine
____ Jet ____ Reciprocating
____ Centrifugal ____ Other

5. Type and color of material

| | From | To |
|---|---|---|
| SANDY LOAM | 0 | 5 |
| " " | 5 | 10 |
| " CLAY | 10 | 15 |
| GREY CLAY | 15 | 17 |
| RED - GREEN SHALE | 17 | 20 |
| GREY SHALE | 20 | 25 |
| GREY SHALE - LAYERED - 1-1' | 25 | 35 |
| White hard Lime layer | | |
| WELLINGTON - DARK | 35 | 48 |

(Use a second sheet if needed)

18. Elevation:

Topography:
____ Hill
____ Slope
____ Upland
____ Valley

19. Remarks:

20. Water well contractor's certification:
This well was drilled under my jurisdiction and this report is true to the best of my knowledge and belief.
Business name PAUL'S INC License No. #125
Address HESSTON, KNS
Signed Paul Burkhart Authorized representative Date 8-30-77

Forward the white, blue and pink copies to the Department of Health and Environment

Form WWC-5

MI-1023

T 22 R 1 (E) W Sec 19 1/4 1/4 1/4 NW SW