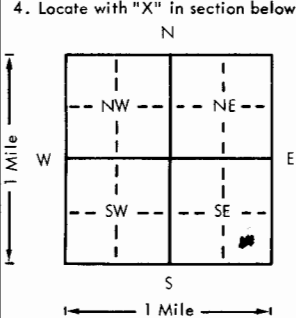


USE TYPEWRITER OR BALL POINT PEN-PRESS FIRMLY, PRINT CLEARLY.

WATER WELL RECORD
KSA 82a-1201-1215

Kansas Department of Health and Environment-Division of Environment
(Water well Contractors)
Topeka, Kansas 66620

1. Location of well: County <u>Harvey</u> Fraction <u>50 1/4 50 1/4 SE</u> Section number <u>26</u> Township number <u>22 S R. 1 E</u> Range number <u>1</u>																						
2. Distance and direction from nearest town or city: <u>Walton</u> Street address of well location if in city: <u>1 1/2 W 1 S an-W 1 S off road</u> 3. Owner of well: <u>Andich Sauerwein</u> R.R. or street: <u>R4</u> City, state, zip code: <u>Newton Kansas</u>																						
4. Locate with "X" in section below: Sketch map: 																						
5. Type and color of material																						
<table border="1"> <thead> <tr> <th>From</th> <th>To</th> <th>Material</th> </tr> </thead> <tbody> <tr> <td></td> <td></td> <td>10 feet cement</td> </tr> <tr> <td></td> <td></td> <td>B soil</td> </tr> <tr> <td></td> <td></td> <td>well gone</td> </tr> <tr> <td></td> <td></td> <td>30 ft Blue shale</td> </tr> <tr> <td></td> <td></td> <td>18 in Limestone</td> </tr> <tr> <td></td> <td></td> <td>Blue shale</td> </tr> </tbody> </table>		From	To	Material			10 feet cement			B soil			well gone			30 ft Blue shale			18 in Limestone			Blue shale
From	To	Material																				
		10 feet cement																				
		B soil																				
		well gone																				
		30 ft Blue shale																				
		18 in Limestone																				
		Blue shale																				
6. Bore hole dia: <u>8 1/2</u> in. Completion date: <u>10-878</u> Well depth: <u>90</u> ft.	7. <input checked="" type="checkbox"/> Cable tool <input type="checkbox"/> Rotary <input type="checkbox"/> Driven <input type="checkbox"/> Dug <input type="checkbox"/> Hollow rod <input type="checkbox"/> Jetted <input type="checkbox"/> Bored <input type="checkbox"/> Reverse rotary																					
8. Use: <input type="checkbox"/> Domestic <input type="checkbox"/> Public supply <input type="checkbox"/> Industry <input type="checkbox"/> Irrigation <input type="checkbox"/> Air conditioning <input checked="" type="checkbox"/> Stock <input type="checkbox"/> Lawn <input type="checkbox"/> Oil field water <input type="checkbox"/> Other																						
9. Casing: Material: <u>blue</u> Height: Above or below Threading: <input type="checkbox"/> Welded <input checked="" type="checkbox"/> Surface: <u>2 1/2</u> in. RMP: <input checked="" type="checkbox"/> PVC <input type="checkbox"/> Weight: <u>900</u> lbs./ft. Dia: <u>6</u> in. to <u>60</u> ft. depth Wall Thickness: inches or Dia. <u>in.</u> to <u>ft.</u> depth gage No. <u>2/10</u>																						
10. Screen: Manufacturer's name: <u>Sunflowr plastic pipe inc</u> Type: <u>RMP</u> Dia: <u>6</u> Slot/gauze: <u>3/32</u> Length: <u>40</u> Set between <u>35</u> ft. and <u>75</u> ft. Gravel pack? <input checked="" type="checkbox"/> Size range of material: <u>1/4 - 5/8</u>																						
11. Static water level: <u>40</u> ft. below land surface Date: <u>10-878</u> mo./day/yr.																						
12. Pumping level below land surfaces: <u>50</u> ft. after <u>1</u> hrs. pumping <u>5</u> g.p.m. <u>ft.</u> after <u>hrs.</u> pumping <u>g.p.m.</u> Estimated maximum yield <u>5</u> g.p.m.																						
13. Water sample submitted: <u>Yes</u> <input checked="" type="checkbox"/> <u>No</u> <input checked="" type="checkbox"/> Date: <u>10-878</u> mo./day/yr.																						
14. Well head completion: <input type="checkbox"/> Pitless adapter <u>24</u> inches above grade																						
15. Well grouted? <input checked="" type="checkbox"/> With: <input type="checkbox"/> Neat cement <input checked="" type="checkbox"/> Bentonite <input type="checkbox"/> Concrete Depth: From <u>100</u> ft. to <u>10</u> ft.																						
16. Nearest source of possible contamination: <u>200</u> ft. Direction: <u>N 1/2</u> Type: <u>logroom</u> Well disinfected upon completion? <input checked="" type="checkbox"/> Yes <input type="checkbox"/> No																						
17. Pump: <input checked="" type="checkbox"/> Not installed Manufacturer's name: _____ HP: _____ Volts: _____ Length of drop pipe: _____ ft. capacity: _____ g.p.m. Type: <input type="checkbox"/> Submersible <input type="checkbox"/> Turbine <input type="checkbox"/> Jet <input type="checkbox"/> Reciprocating <input type="checkbox"/> Centrifugal <input type="checkbox"/> Other																						
18. Elevation:	19. Remarks: <u>Blue shale</u>																					
Topography: <input type="checkbox"/> Hill <input type="checkbox"/> Slope <input checked="" type="checkbox"/> Upland <input type="checkbox"/> Valley	20. Water well contractor's certification: This well was drilled under my jurisdiction and this report is true to the best of my knowledge and belief. <u>Grant Budde 221</u> Business name: <u>R4 Newton Kansas</u> License No. _____ Address: _____ Signed: <u>Grant Budde</u> Date: <u>12-278</u> Authorized representative																					

Forward the white, blue and pink copies to the Department of Health and Environment

Form WWC-5