USE TYPEWRITER OR BALL POINT PEN-PRESS FIRMLY, PRINT CLEARLY.

WATER WELL RECORD
KSA 82a-1201-1215

Kansas Department of Health and Environment-Division of Environment
(Water well Contractors)
Topeka, Kansas 66620

1. Location of well:	County	Fraction	Section number	Township number	Range number
	HARVEY	NE ~~SE~~ 1/4 SE 1/4 SW 1/4	33	T 22 S	R 1 (E) W

2. Distance and direction from nearest town or city: 1 - North - 1 East of Newton
Street address of well location if in city:

3. Owner of well: WANDA K LASSEN
R.R. or street:
City, state, zip code: Newton, Kansas

4. Locate with "X" in section below:

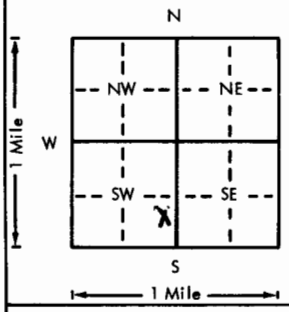

Sketch map:

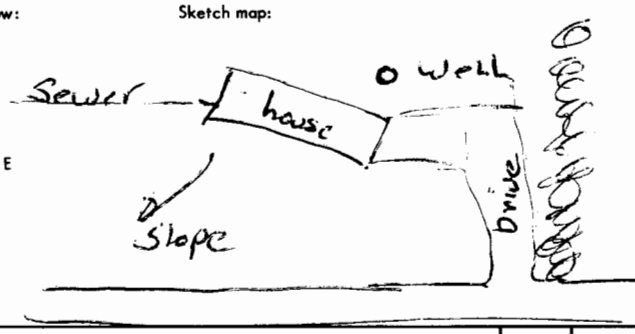

6. Bore hole dia. 12 in. Completion date 7/12/76
Well depth ____ ft.

7. __ Cable tool X Rotary __ Driven __ Dug
__ Hollow rod __ Jetted __ Bored __ Reverse rotary

8. Use: X Domestic __ Public supply __ Industry
__ Irrigation __ Air conditioning __ Stock
__ Lawn __ Oil field water __ Other

9. Casing: Material Plastic Height Above or below
Threaded ____ Welded X Surface 12" in.
RMP ____ PVC X Weight 3.23 lbs./ft.
Dia. 6 in. to 24 ft. depth Wall Thickness: inches or
Dia. ____ in. to ____ ft. depth gage No. .255

5. Type and color of material	From	To
top Loam	0	2
Light br clay	2	7
Small Sand	7	9
Light br. clay	9	16
Small to med Sand	16	21
blue shale	21	22
dark wellington Shale	22	24

(Use a second sheet if needed)

10. Screen: Manufacturer's name Robin-Tech Over Slot
Type PVC Plastic Dia. 6"
Slot/gauze .064 Length 15'
Set between 15 ft. and 30 ft.
____ ft. and ____ ft.
Gravel pack? X Size range of material 1/8-1/4

11. Static water level: mo./day/yr.
11 ft. below land surface Date 7/12/76

12. Pumping level below land surfaces:
19 ft. after 1 hrs. pumping 20 g.p.m.
____ ft. after ____ hrs. pumping ____ g.p.m.
Estimated maximum yield 20 g.p.m.

13. Water sample submitted: mo./day/yr.
__ Yes X No Date

14. Well head completion:
X Pitless adapter 12" Inches above grade

15. Well grouted? yes
With: X Neat cement __ Bentonite __ Concrete
Depth: From 0 ft. to 10 ft.

16. Nearest source of possible contamination: house
ft. 70 Direction South Type Sewer
Well disinfected upon completion? X Yes __ No

17. Pump: __ Not installed
Manufacturer's name Valley
Model number S1209 HP 1/2 Volts 230
Length of drop pipe 20' ft. capacity 20 g.p.m.
Type:
X Submersible __ Turbine
__ Jet __ Reciprocating
__ Centrifugal __ Other

18. Elevation:

Topography:
__ Hill
__ Slope
X Upland
__ Valley

19. Remarks:

20. Water well contractor's certification:
This well was drilled under my jurisdiction and this report is true to the best of my knowledge and belief.
Business name PAUL'S INC License No. 125
Address Hesston Kansas
Signed Paul Bauchart Date 7/12/76
Authorized representative

22 T — 1 R W 33 Sec NE 1/4 SE 1/4 SW 1/4

Forward the white, blue and pink copies to the Department of Health and Environment

Form WWC-5

M1-1023