


1 LOCATION OF WATER WELL: County: Harvey Fraction: SE 1/4 NE 1/4 SE 1/4 Section Number: 18 Township Number: T 22 S Range Number: R 1 E/W

Distance and direction from nearest town or city street address of well if located within city?  
4 mi N of Newton

2 WATER WELL OWNER: Brent Lehman  
 RR#, St. Address, Box #: 7625 N Anderson Rd  
 City, State, ZIP Code: Newton, KS 67114  
 Board of Agriculture, Division of Water Resources  
 Application Number:

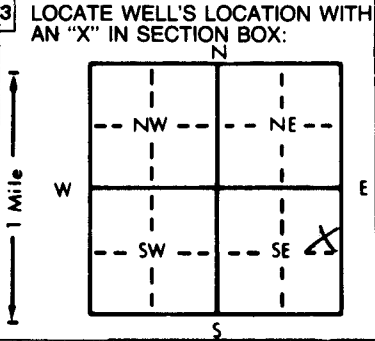

4 DEPTH OF COMPLETED WELL: 3.2 ft. ELEVATION:  
 Depth(s) Groundwater Encountered 1. .... ft. 2. .... ft. 3. .... ft.  
 WELL'S STATIC WATER LEVEL: 10 ft. below land surface measured on mo/day/yr 1-17-00  
 Pump test data: Well water was 14 ft. after 3 1/4 hours pumping 25 gpm  
 Est. Yield ..... gpm Well water was ..... ft. after ..... hours pumping ..... gpm  
 Bore Hole Diameter: 8 in. to 33 in. and ..... in. to ..... in.  
 WELL WATER TO BE USED AS:  
 1 Domestic     2 Irrigation     3 Feedlot     4 Industrial  
 5 Public water supply     6 Oil field water supply     7 Lawn and garden only  
 8 Air conditioning     9 Dewatering     10 Monitoring well  
 11 Injection well     12 Other (Specify below)  
 Was a chemical/bacteriological sample submitted to Department? Yes.....No X.....; If yes, mo/day/yr sample was submitted  
 Water Well Disinfected? Yes X No

5 TYPE OF BLANK CASING USED:  
 1 Steel     2 PVC     3 RMP (SR)     4 ABS     5 Wrought iron     6 Asbestos-Cement     7 Fiberglass     8 Concrete tile     9 Other (specify below)  
 Blank casing diameter: 5 in. to 19 in. Dia. 5 in. to 32 in. Dia. .... in. to .... in.  
 Casing height above land surface: 12 in., weight 2.29 lbs./ft. Wall thickness or gauge No. 160  
 TYPE OF SCREEN OR PERFORATION MATERIAL:  
 1 Steel     2 Brass     3 Stainless steel     4 Galvanized steel     5 Fiberglass     6 Concrete tile     7 Torch cut     8 RMP (SR)     9 ABS     10 PVC     11 Other (specify)     12 None used (open hole)  
 SCREEN OR PERFORATION OPENINGS ARE:  
 1 Continuous slot     2 Louvered shutter     3 Mill slot     4 Key punched     5 Gauzed wrapped     6 Wire wrapped     7 Torch cut     8 Saw cut     9 Drilled holes     11 None (open hole)  
 SCREEN-PERFORATED INTERVALS: From 19 ft. to 29 ft. From ..... ft. to ..... ft.  
 GRAVEL PACK INTERVALS: From 18 ft. to 33 ft. From ..... ft. to ..... ft.

6 GROUT MATERIAL:  1 Neat cement     2 Cement grout     3 Bentonite     4 Other  
 Grout Intervals: From 3 ft. to 18 ft. From ..... ft. to ..... ft.  
 What is the nearest source of possible contamination:  
 1 Septic tank     2 Sewer lines     3 Watertight sewer lines     4 Lateral lines     5 Cess pool     6 Seepage pit     7 Pit privy     8 Sewage lagoon     9 Feedyard     10 Livestock pens     11 Fuel storage     12 Fertilizer storage     13 Insecticide storage     14 Abandoned water well     15 Oil well/Gas well     16 Other (specify below)  
 Direction from well? N-NW How many feet? 250

FROM	TO	LITHOLOGIC LOG	FROM	TO	PLUGGING INTERVALS
0	9	Br Clay			
9	28	F-C Sand			
28	33	Shale			

7 CONTRACTOR'S OR LANDOWNER'S CERTIFICATION: This water well was  (1) constructed, (2) reconstructed, or (3) plugged under my jurisdiction and was completed on (mo/day/year) 1-17-00 and this record is true to the best of my knowledge and belief. Kansas Water Well Contractor's License No. 447 This Water Well Record was completed on (mo/day/yr) 1-18-00 under the business name of Miller Drilling by (signature) E. Miller

OFFICE USE ONLY