


WATER WELL RECORD

Form WWC-5

Division of Water Resources; App. No.

1 LOCATION OF WATER WELL: County: Harrey, Fraction: Se 1/4 Se 1/4 NW 1/4, Section Number: 35, Township Number: T 22 S, Range Number: R 1 EW

2 WATER WELL OWNER: Daryl Cooper, RR#, St. Address, Box #: 1206 Allison, City, State, ZIP Code: Newton, Ke 67114

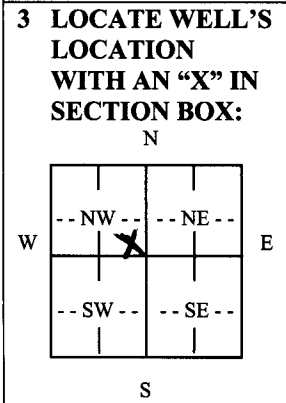

3 LOCATE WELL'S LOCATION WITH AN 'X' IN SECTION BOX: 4 DEPTH OF COMPLETED WELL: 6.5 ft. Depth(s) Groundwater Encountered (1) 2.0 ft. (2) ... (3) ... WELL'S STATIC WATER LEVEL: 1.3 ft. below land surface measured on mo/day/yr 3-14-08

5 TYPE OF CASING USED: 1 Steel, 2 PVC, 3 RMP (SR), 4 ABS, 5 Wrought Iron, 6 Asbestos-Cement, 7 Fiberglass, 8 Concrete tile, 9 Other (specify below)

6 GROUT MATERIAL: 1 Neat cement, 2 Cement grout, 3 Bentonite, 4 Other. Grout Intervals: From 0 ft. to 1.5 ft. What is the nearest source of possible contamination: 1 Septic tank, 2 Sewer lines, 3 Watertight sewer lines, 4 Lateral lines, 5 Cess pool, 6 Seepage pit, 7 Pit privy, 8 Sewage lagoon, 9 Feedyard, 10 Livestock pens, 11 Fuel storage, 12 Fertilizer Storage, 13 Insecticide Storage, 14 Abandoned water well, 15 Oil well/gas well, 16 Other (specify below)

Table with columns: FROM, TO, LITHOLOGIC LOG, FROM, TO, PLUGGING INTERVALS. Rows: 0-15 Clay, 15-25 Sand, 25-55 Blue Shale, 55-56 Possible Water, 56-65 Gray Shale

7 CONTRACTOR'S OR LANDOWNER'S CERTIFICATION: This water well was (1) constructed, (2) reconstructed, or (3) plugged under my jurisdiction and was completed on (mo/day/year) 3-14-08 and this record is true to the best of my knowledge and belief.

INSTRUCTIONS: Use typewriter or ball point pen. PLEASE PRESS FIRMLY and PRINT clearly. Please fill in blanks, underline or circle the correct answers. Send top three copies to Kansas Department of Health and Environment, Bureau of Water, Geology Section, 1000 SW Jackson St., Suite 420, Topeka, Kansas 66612-1367.