WATER WELL PLUGGING RECORD Form WWC-5P KSA 82a-1212 ID NO.

WELL #1

1 LOCATION OF WATER WELL: County: GREENWOOD	Fraction	Section Number	Township Number	Range Number
	SE ¼ SE ¼ SE ¼ SE ¼	34	22 T S	12 ☑ E ☐ W

Street/Rural Address of Well Location; if unknown, distance & direction from nearest town or intersection: If at owner's address, check here ☐ APPROXIMATELY 300' NORTH OF THE INTERSECTION OF 330TH & BB Rd IN GREENWOOD COUNTY

Global Positioning Systems (GPS) information:
Latitude: -96.067473 (in decimal degrees)
Longitude: 38.085570 (in decimal degrees)
Elevation: 1077
Horizontal Datum: ☐ WGS84, ☑ NAD83, ☐ NAD27
Collection Method:
☐ GPS unit (Make/Model:)
☑ Digital Map/Photo, ☐ Topographic Map, ☐ Land Survey
Est. Accuracy: ☐ < 3 m, ☐ 3-5 m, ☐ 5-15 m, ☑ > 15 m

2 WATER WELL OWNER: DENNIS D BAYSINGER
RR#, St. Address, Box #: 3323 BB Rd
City, State ZIP Code: MAIDISON, KS 66860

3 MARK WELL'S LOCATION WITH AN "X" IN SECTION BOX:

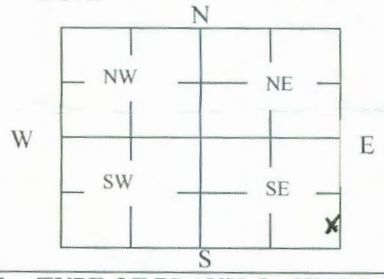

4 DEPTH OF WELL 12.5 ft.

WELL'S STATIC WATER LEVEL 8 ft

WELL WAS USED AS:

☑ Domestic ☐ Irrigation ☐ Feedlot ☐ Industrial
☐ Public Water Supply ☐ Oil Field Water Supply ☐ Domestic (Lawn & Garden) ☐ Air Conditioning
☐ Dewatering ☐ Monitoring ☐ Injection Well ☐ Other

Was a chemical/bacteriological sample submitted to Department? Yes ☐ No ☑

5 TYPE OF BLANK CASING USED:

☐ Steel ☐ PVC ☐ RMP (SR) ☐ ABS ☐ Wrought ☐ Asbestos-Cement ☐ Fiberglass ☐ Concrete Tile ☐ Other (Specify below) 3' diameter

Blank casing diameter 3' in. Was casing pulled? Yes ☑ No ☐ If yes, how much 4.5'
Casing height above or below land surface 60 in.

6 GROUT PLUG MATERIAL: ☐ Neat cement ☐ Cement grout ☑ Bentonite ☐ Other

Grout Plug Intervals: From 4.25 ft. to 4.5 ft., From ____ ft. to ____ ft., From ____ ft. to ____ ft.

What is the nearest source of possible contamination:

☐ Septic tank ☐ Sewer lines ☐ Watertight sewer lines ☐ Lateral lines ☐ Cess pool
☐ Seepage pit ☐ Pit privy ☐ Sewage lagoon ☐ Feedyard ☐ Livestock pens
☐ Fuel storage ☐ Fertilizer storage ☐ Insecticide storage ☐ Abandoned water well ☐ Oil well/Gas well
☐ Other (specify below) NONE
Direction from well?
How many feet?

FROM	TO	PLUGGING MATERIALS	FROM	TO	PLUGGING MATERIALS
0	4.25	TOP SOIL			
4.25	4.5	BENTONITE			
4.5	13'	WASHED ROCK/SAND			

7 CONTRACTOR'S OR LANDOWNER'S CERTIFICATION: This water well was plugged under my jurisdiction and was completed on (mo/day/year) 12-27-2016 and this record is true to the best of my knowledge and belief. Kansas Water Well Contractor's License No. ____. This Water Well Record was completed on (mo/day/year) 10-20-2017 under the business name of Greenwood County Conservation District by (signature) Leila Sherman

Send one white copy to Kansas Department of Health & Environment, Geology Section, 1000 SW Jackson Street, Ste. 420, Topeka, KS 66612-1367. Send one copy to WATER WELL OWNER and retain one for your records.
Visit us at http://www.kdheks.gov/waterwell/index.html Telephone 785-296-5524.

Plan Map

Customer(s): DENNIS D BAYSINGER
District: GREENWOOD COUNTY CONSERVATION DISTRICT

Field Office: EUREKA SERVICE CENTER
Agency: NRCS
Assisted By: GARAN BELT

Legend

Practice name

- Well Decommissioning
- 2016 SCS
- plss_a_ks073

RECEIVED
OCT 24 2017
BUREAU OF WATER

160 0 160 320 480 640 Feet

N

Soil data has been compiled to National Map Accuracy Standards of 1:12,000 scale. Use of this data at larger scales may introduce the appearance of inaccurate line placement.