


1 LOCATION OF WATER WELL: County: <b>Coffey</b>	Fraction <b>NW ¼ NW ¼ NW ¼</b>	Section Number <b>33</b>	Township Number <b>T 22 S</b>	Range Number <b>R 14</b> <b>(E/W)</b>
--	-----------------------------------	-----------------------------	----------------------------------	--

Distance and direction from nearest town or city street address of well if located within city?  
**602 Main, Gridley**

2 WATER WELL OWNER: **Rodgers Oil Company, Inc.**  
 RR#, St. Address, Box # : **P.O. Box 231**  
 City, State, ZIP Code : **Gridley, Kansas 66852**  
 Board of Agriculture, Division of Water Resources  
 Application Number:

3 LOCATE WELL'S LOCATION WITH AN "X" IN SECTION BOX:

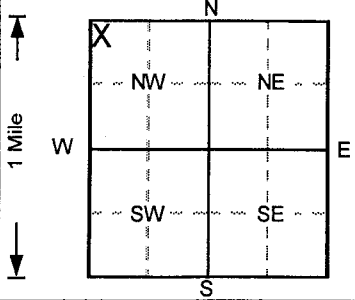

4 DEPTH OF COMPLETED WELL ..... **14** ..... ft. ELEVATION: .....

Depth(s) Groundwater Encountered 1. .... ft. 2. .... ft. 3. .... ft.

WELL'S STATIC WATER LEVEL ..... ft. below land surface measured on mo/day/yr .....

Pump test data: Well water was ..... **NA** ..... ft. after ..... hours pumping ..... gpm

Est. Yield .. **NA** .. gpm: Well water was ..... ft. after ..... hours pumping ..... gpm

Bore Hole Diameter ..... **8** ..... in. to ..... **14** ..... ft., and ..... in. to ..... ft.

WELL WATER TO BE USED AS: 5 Public water supply 8 Air conditioning 11 Injection well  
 1 Domestic 3 Feedlot 6 Oil field water supply 9 Dewatering 12 Other (Specify below)  
 2 Irrigation 4 Industrial 7 Lawn and garden only **(10) Monitoring well**

Was a chemical/bacteriological sample submitted to Department? Yes.....No  ..; If yes, mo/day/yr sample was submitted  
 Water Well Disinfected? Yes No

5 TYPE OF BLANK CASING USED:

1 Steel	3 RMP (SR)	5 Wrought iron	8 Concrete tile	CASING JOINTS: Glued ..... Clamped .....
<b>(2) PVC</b>	4 ABS	6 Asbestos-Cement	9 Other (specify below)	Welded .....
		7 Fiberglass		Threaded. <input checked="" type="checkbox"/>

Blank casing diameter ..... **2** ..... in. to ..... **4** ..... ft., Dia ..... in. to ..... ft., Dia ..... in. to ..... ft.

Casing height above land surface ..... **0** ..... in., weight ..... lbs./ft. Wall thickness or gauge No. .... **Sch. 40** .....

TYPE OF SCREEN OR PERFORATION MATERIAL

1 Steel	3 Stainless steel	5 Fiberglass	<b>(7) PVC</b>	10 Asbestos-cement
2 Brass	4 Galvanized steel	6 Concrete tile	8 RMP (SR)	11 Other (specify) .....
			9 ABS	12 None used (open hole)

SCREEN OR PERFORATION OPENINGS ARE:

1 Continuous slot	<b>(3) Mill slot</b>	5 Gauzed wrapped	8 Saw cut	11 None (open hole)
2 Louvered shutter	4 Key punched	6 Wire wrapped	9 Drilled holes	
		7 Torch cut	10 Other (specify) .....	

SCREEN-PERFORATED INTERVALS: From ..... **4** ..... ft. to ..... **14** ..... ft., From ..... ft. to ..... ft.  
 From ..... ft. to ..... ft., From ..... ft. to ..... ft.

GRAVEL PACK INTERVALS: From ..... **2.5** ..... ft. to ..... **14** ..... ft., From ..... ft. to ..... ft.  
 From ..... ft. to ..... ft., From ..... ft. to ..... ft.

6 GROUT MATERIAL: 1 Neat cement 2 Cement grout **(3) Bentonite** **(4) Other Concrete** .....

Grout Intervals: From ..... **0** ..... ft. to ..... **1** ..... ft., From ..... **1** ..... ft. to ..... **2.5** ..... ft., From ..... ft. to ..... ft.

What is the nearest source of possible contamination:

1 Septic tank	4 Lateral lines	7 Pit privy	10 Livestock pens	14 Abandoned water well
2 Sewer lines	5 Cess pool	8 Sewage lagoon	11 Fuel storage	15 Oil well/Gas well
3 Watertight sewer lines	6 Seepage pit	9 Feedyard	12 Fertilizer storage	16 Other (specify below)
			13 Insecticide storage	

Direction from well? How many feet?

FROM	TO	LITHOLOGIC LOG	FROM	TO	PLUGGING INTERVALS
0	1	Clay and gravel (fill),			
1	5	Clay, sl. silty, moist, stiff, no odor, Dark Brow			
5	9	Clay, moist, stiff, no odor, Brown w/rust mottl			
9	10	Limestone, hard, dry, Yellow			
10	11	Shale, silty, sl. moist, weathered, Grayish Gree			
11	11.5	Limestone, hard, dry, Yellow			
11.5	14	Shale, silty, moist, weathered, no odor, Grayis			
					MW11 , Tag # 00368461 , Flushmount
					Project Name: Rodger's Oil Company, Inc. - Monitoring
					GeoCore # 1031 , KDHE # U3 016 12642

7 CONTRACTOR'S OR LANDOWNER'S CERTIFICATION: This water well was **(1)** constructed, (2) reconstructed, or (3) plugged under my jurisdiction and was completed on (mo/day/year) ..... **8/21/2006** ..... and this record is true to the best of my knowledge and belief.  
 Kansas Water Well Contractor's License No. .... **527** ..... This Water Well Record was completed on (mo/day/yr) ..... **8/29/2006** .....  
 under the business name of **GeoCore, Inc.** by (signature) *Don Wolf*