

WATER WELL RECORD Form WWC-5

☒ Original Record ☐ Correction ☐ Change in Well Use

Division of Water
Resources App. No.

MW-6R

Well ID

1 LOCATION OF WATER WELL: County: Coffey Fraction SW 1/4 SW 1/4 SW 1/4 SW 1/4 Section Number 28 Township Number T 22 S Range Number R 14 ☒ E ☐ W

2 WELL OWNER: Last Name: Dale First: Rodgers Street or Rural Address where well is located (if unknown, distance and direction from nearest town or intersection): If at owner's address, check here: ☐
Business: Rodgers Oil
Address: 602 Main Street
City: Gridley State: KS ZIP: 66852
2nd + Main St.

3 LOCATE WELL WITH "X" IN SECTION BOX:
N
W E
S
1 mile
4 DEPTH OF COMPLETED WELL: 13.4 ft.
Depth(s) Groundwater Encountered: 1) 7.15 ft. 2) ft. 3) ft. or 4) ☐ Dry Well
WELL'S STATIC WATER LEVEL: ft.
☒ below land surface, measured on (mo-day-yr) 8-20-2020
☐ above land surface, measured on (mo-day-yr)
Pump test data: Well water was ft.
after hours pumping gpm
Well water was ft.
after hours pumping gpm
Estimated Yield: gpm
Bore Hole Diameter: 8.75 in. to 13.4 ft. and in. to ft.
5 Latitude: 38.09827 (decimal degrees)
Longitude: 95.88479 (decimal degrees)
Horizontal Datum: ☐ WGS 84 ☐ NAD 83 ☐ NAD 27
Source for Latitude/Longitude:
☐ GPS (unit make/model:)
(WAAS enabled? ☐ Yes ☐ No)
☒ Land Survey ☐ Topographic Map
☐ Online Mapper:
6 Elevation: 1138.27 ft. ☐ Ground Level ☒ TOC
Source: ☒ Land Survey ☐ GPS ☐ Topographic Map
☐ Other

7 WELL WATER TO BE USED AS:
1. Domestic: ☐ Household ☐ Lawn & Garden ☐ Livestock
2. ☐ Irrigation
3. ☐ Feedlot
4. ☐ Industrial
5. ☐ Public Water Supply: well ID
6. ☐ Dewatering: how many wells?
7. ☐ Aquifer Recharge: well ID
8. ☒ Monitoring: well ID MW-6R
9. Environmental Remediation: well ID
☐ Air Sparge ☐ Soil Vapor Extraction
☐ Recovery ☐ Injection
10. ☐ Oil Field Water Supply: lease
11. Test Hole: well ID
☐ Cased ☐ Uncased ☐ Geotechnical
12. Geothermal: how many bores?
a) Closed Loop ☐ Horizontal ☐ Vertical
b) Open Loop ☐ Surface Discharge ☐ Inj. of Water
13. ☐ Other (specify):

Was a chemical/bacteriological sample submitted to KDHE? ☐ Yes ☒ No If yes, date sample was submitted:
Water well disinfected? ☐ Yes ☒ No

8 TYPE OF CASING USED: ☐ Steel ☒ PVC ☐ Other CASING JOINTS: ☐ Glued ☐ Clamped ☐ Welded ☒ Threaded
Casing diameter 2 in. to 3.4 ft., Diameter in. to ft., Diameter in. to ft.
Casing height above land surface 0 in. Weight lbs./ft. Wall thickness or gauge No. Sch 40

TYPE OF SCREEN OR PERFORATION MATERIAL:
☐ Steel ☐ Stainless Steel ☐ Fiberglass ☒ PVC ☐ Other (Specify)
☐ Brass ☐ Galvanized Steel ☐ Concrete tile ☐ None used (open hole)

SCREEN OR PERFORATION OPENINGS ARE:
☐ Continuous Slot ☒ Mill Slot ☐ Gauze Wrapped ☐ Torch Cut ☐ Drilled Holes ☐ Other (Specify)
☐ Louvered Shutter ☐ Key Punched ☐ Wire Wrapped ☐ Saw Cut ☐ None (Open Hole)

SCREEN-PERFORATED INTERVALS: From 3.4 ft. to 13.4 ft., From ft. to ft., From ft. to ft.
GRAVEL PACK INTERVALS: From 1.4 ft. to 13.4 ft., From ft. to ft., From ft. to ft.

9 GROUT MATERIAL: ☐ Neat cement ☐ Cement grout ☒ Bentonite ☒ Other Cement fed
Grout Intervals: From 0 ft. to 1 ft., From 1 ft. to 1.4 ft., From ft. to ft.

Nearest source of possible contamination:
☐ Septic Tank ☐ Lateral Lines ☐ Pit Privy ☐ Livestock Pens ☐ Insecticide Storage
☐ Sewer Lines ☐ Cess Pool ☐ Sewage Lagoon ☐ Fuel Storage ☐ Abandoned Water Well
☐ Watertight Sewer Lines ☐ Seepage Pit ☐ Feedyard ☐ Fertilizer Storage ☐ Oil Well/Gas Well
☒ Other (Specify) Contaminated Site
Direction from well? Distance from well? ft.


10 FROM	TO	LITHOLOGIC LOG	FROM	TO	LITHO. LOG (cont.) or PLUGGING INTERVALS
0	5	Clay, dark brown, hard, moist			
5	10	Clay, dark brown, stiff, damp			
10	13.4	Clay, dark brown, stiff, moist, slightly silty			

11 CONTRACTOR'S OR LANDOWNER'S CERTIFICATION: This water well was ☒ constructed, ☐ reconstructed, or ☐ plugged under my jurisdiction and was completed on (mo-day-year) 8-20-20 and this record is true to the best of my knowledge and belief.
Kansas Water Well Contractor's License No. 604 This Water Well Record was completed on (mo-day-year) 9/24/2020
under the business name of Environmental Priority Service, Inc. Signature *J. H. H. H.*

Mail 1 white copy along with a fee of \$5.00 for each constructed well to: Kansas Department of Health and Environment, Bureau of Water, GWTS Section, 1000 SW Jackson St., Suite 420, Topeka, Kansas 66612-1367. Mail one to Water Well Owner and retain one for your records. Telephone 785-296-5524.
Visit us at <http://www.kdheks.gov/waterwell/index.html> KSA 82a-1212 Revised 7/10/2015

*Returned for corrections
11/8/20*

NW 13
 267 WEST
 207 NORTH
 NW 10
 267 EAST
 137 NORTH

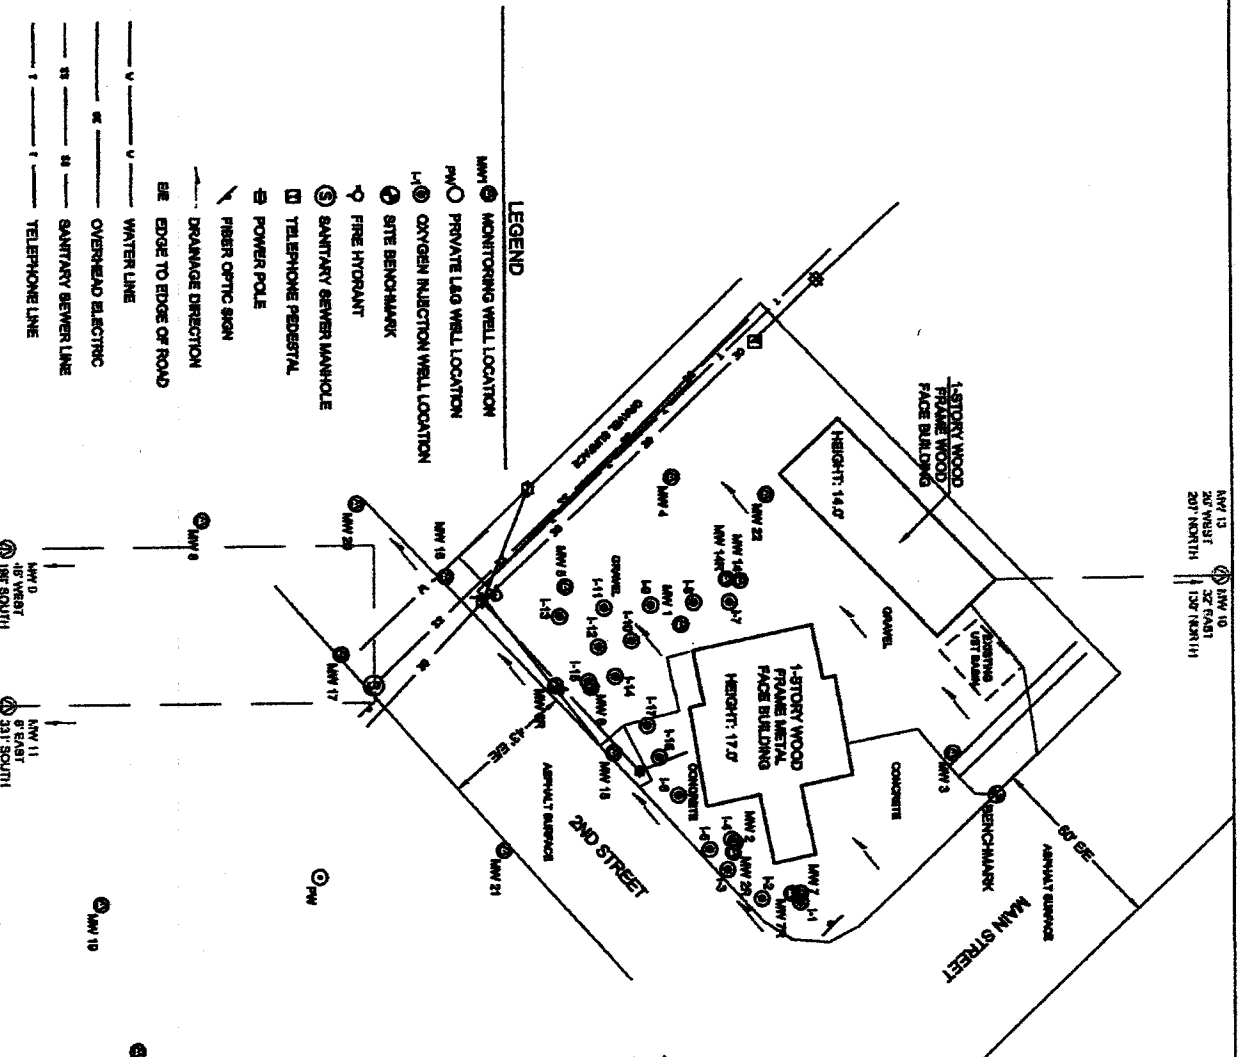


Point	North Coordinates	East Coordinates	Distance From SE Cor. Sec. 28	Elev. Top of Rim or PVC Pipe	Elev. Top of PVC Pipe	Latitude	Longitude
SE Cor. Sec. 28, T28S, R14E	10000	10000					

Description: "T" Equivalents out at North corner.
 B.M. B.W. = 1143.54
 Scale: 1"=40'
 N
 SMH CONSULTANTS
 C.M. Engineering • Land Surveying • Landscape Architecture
 www.smhconsultants.com
 Manhattan, KS - HQ P: (785) 778-0641 • Dodge City, KS P: (620) 285-1882
 Overland Park, KS P: (913) 444-8616 • Colorado Springs, CO P: (719) 428-8877
 Drawn by: DBA Project #2008MAN1240 DD #119 TDS #82

REMEDIAL SITE SURVEY RODGERS OIL COMPANY City of Ordley, Coffey County, Kansas

N:\KDHE Contracts\ENVIRONMENTAL SVCS CONTRACT 41578\PROJECTS - UST T&M\27216354.01 - Rodgers Oil, Gridley - SRP\AutoCAD\20200508\Rodgers Oil.dwg May 15, 2020 - 1:50pm Layout Name: D4 By: 4470daw

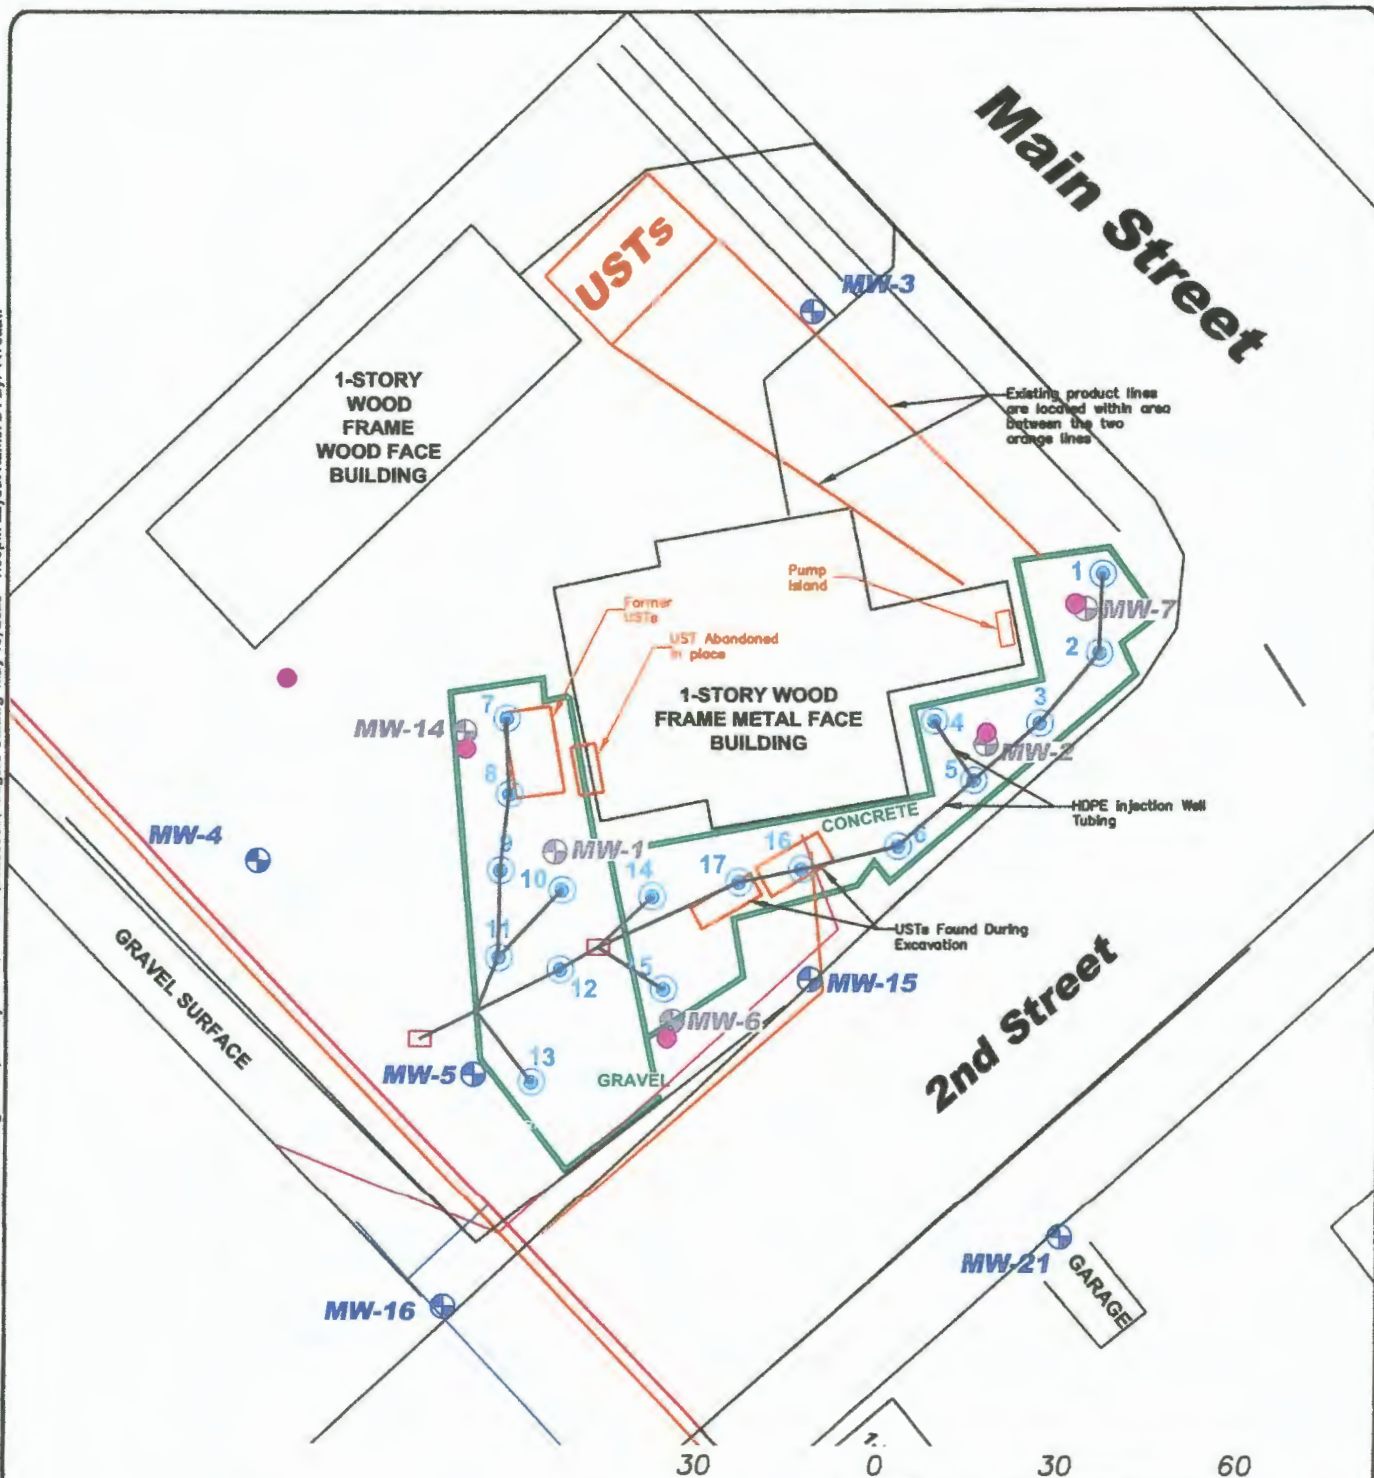

LEGEND

- Existing Monitoring Wells
- Plugged Monitoring Wells
- Oxygen Injection Well
- Tubing Junction Box
- Extents of Excavation
- Planned Replacement Monitoring Wells

SCALE

FEET

SCS ENGINEERS

8575 W. 110th St, Ste. 100
Overland Park, Kansas 66210
PH. (913) 681-0030 FAX. (913) 681-0012

FIGURE 1.4

**PLANNED REPLACEMENT MONITORING WELLS
RODGERS OIL COMPANY
SECOND AND MAIN, GRIDLEY, KANSAS**

CHK. BY: JDJ	DWN. BY: DAW	DSN. BY: DAW	PROJ. NO. 27216354.00
PROJ. MGR: SLM	DATE: 5/15/20	CADD FILE: RODGERS OIL.dwg	DRAWING NO. 1.4