USE TYPEWRITER OR BALL POINT PEN-PRESS FIRMLY, PRINT CLEARLY.

WATER WELL RECORD
KSA 82a-1201-1215

Kansas Department of Health and Environment-Division of Environment
(Water well Contractors)
Topeka, Kansas 66620

1. Location of well:	County	Fraction	Section number	Township number	Range number
	HARVEY	NE 1/4 SW 1/4 SW 1/4	6	T 22 S	R 2 E E/W

2. Distance and direction from nearest town or city: FROM WALTON 3 NORTH 1 EAST
Street address of well location if in city:

3. Owner of well: RAY Trotter
R.R. or street: 736 N. Broadway
City, state, zip code: Wichita, Kansas

4. Locate with "X" in section below:

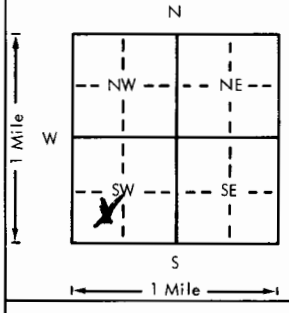

Sketch map:

6. Bore hole dia. 8 in. Completion date
Well depth 44 ft. 3-21-78

7. __ Cable tool X Rotary __ Driven __ Dug
__ Hollow rod __ Jetted __ Bored __ Reverse rotary

8. Use: __ Domestic __ Public supply __ Industry
__ Irrigation __ Air conditioning X Stock
__ Lawn __ Oil field water __ Other

9. Casing: Material Plastic Weight: Above or below
Threaded __ Welded __ Surface 18 in.
RMP X PVC __ Weight __ lbs./ft.
Dia. 5 in. to 24 ft. depth Wall Thickness: inches or
Dia. __ in. to __ ft. depth gage No. 200

5. Type and color of material	From	To
CLAY	0	10
SAND - FINE	10	20
CLAY	20	35
SHALE	35	44
(Use a second sheet if needed)		

10. Screen: Manufacturer's name Sunflower Plastic Pipe
Type 200 Dia. 5"
Slot/gauze Slot 1/16 Length 40'
Set between 24 ft. and 44 ft.
ft. and ft.
Gravel pack? Yes Size range of material 1/8-1/4

X Static water level: mo./day/yr.
14 ft. below land surface Date 9-21-78

12. Pumping level below land surfaces:
ft. after hrs. pumping g.p.m.
ft. after hrs. pumping g.p.m.
Estimated maximum yield g.p.m.

13. Water sample submitted: mo./day/yr.
__ Yes X No Date

14. Well head completion:
__ Pitless adapter 18 Inches above grade

15. Well grouted? Yes
With: __ Neat cement __ Bentonite X Concrete
Depth: From 0 ft. to 10 ft.

16. Nearest source of possible contamination:
ft. 100' Direction NORTH Type FEEDLOT
Well disinfected upon completion? __ Yes X No

17. Pump: X Not installed
Manufacturer's name
Model number HP Volts
Length of drop pipe ft. capacity g.p.m.
Type:
__ Submersible __ Turbine
__ Jet __ Reciprocating
__ Centrifugal __ Other

18. Elevation:

Topography:
__ Hill
X Slope
__ Upland
__ Valley

19. Remarks:

20. Water well contractor's certification:
This well was drilled under my jurisdiction and this report is true to the best of my knowledge and belief.
Martin Supply 362
Business name License No.
Address 300 West 22nd, N. Newton
Signed Authorized Representative Date 3-21-78

T 22 R 2 E Sec 6 NE 1/4 1/4 1/4 KS SW SW

Forward the white, blue and pink copies to the Department of Health and Environment

Form WWC-5

MI-1023