


1 LOCATION OF WATER WELL: County: Harvey Fraction: NE 1/4 NW 1/4 NE 1/4 Section Number: 32 Township Number: T 22 S Range Number: R 2 EW

Distance and direction from nearest town or city street address of well if located within city?
E 700m Union on I-5, 5m E 4-N and 1/2 E

2 WATER WELL OWNER: Adolph Satter Board of Agriculture, Division of Water Resources
 RR#, St. Address, Box #: Walton Kansas Application Number:

3 LOCATE WELL'S LOCATION WITH AN "X" IN SECTION BOX:

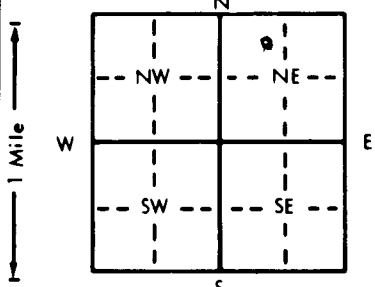

4 DEPTH OF COMPLETED WELL: 61 ft. ELEVATION:

Depth(s) Groundwater Encountered: 1. 1 ft. 2. 1 ft. 3. 1 ft.
 WELL'S STATIC WATER LEVEL: 25 ft. below land surface measured on mo/day/yr May 9, 1990
 Pump test data: Well water was 30 ft. after 1 hours pumping 12 gpm
 Est. Yield: 15 gpm: Well water was 30 ft. after 1 hours pumping 12 gpm
 Bore Hole Diameter: 8 in. to 61 ft., and 61 in. to 61 ft.
 WELL WATER TO BE USED AS:
 Domestic Feedlot Oil field water supply Dewatering Injection well
 Irrigation Industrial Lawn and garden only Monitoring well
 Was a chemical/bacteriological sample submitted to Department? Yes No If yes, mo/day/yr sample was submitted
 Water Well Disinfected? Yes No

5 TYPE OF BLANK CASING USED:
 1 Steel 3 RMP (SR) 5 Wrought iron 8 Concrete tile CASING JOINTS: Glued Clamped
 2 PVC 4 ABS 6 Asbestos-Cement Other (specify below) S.D.R.26 Welded
 7 Fiberglass Threaded

Blank casing diameter: 2 in. to 2 ft., Dia. 200 in. to 200 ft., Dia. 3/16 in. to 3/16 ft.
 Casing height above land surface: 2 ft. in., weight 200 lbs./ft. Wall thickness or gauge No. 3/16

TYPE OF SCREEN OR PERFORATION MATERIAL:
 1 Steel 3 Stainless steel 5 Fiberglass 8 RMP (SR) Other (specify) S.D.R.26
 2 Brass 4 Galvanized steel 6 Concrete tile 9 ABS 12 None used (open hole)

SCREEN OR PERFORATION OPENINGS ARE:
 1 Continuous slot 3 Mill slot 5 Gauzed wrapped 8 Saw cut 11 None (open hole)
 2 Louvered shutter 4 Key punched 6 Wire wrapped 9 Drilled holes

SCREEN-PERFORATED INTERVALS: From Top 31 ft. to 30 ft., From 30 ft. to 30 ft.
 GRAVEL PACK INTERVALS: From 13 ft. to 61 ft., From 61 ft. to 61 ft.

6 GROUT MATERIAL: Neat cement 2 Cement grout 3 Bentonite 4 Other
 Grout Intervals: From 3 ft. to 13 ft., From 13 ft. to 13 ft., From 13 ft. to 13 ft., From 13 ft. to 13 ft.

What is the nearest source of possible contamination:
 1 Septic tank 4 Lateral lines 7 Pit privy Livestock pens 14 Abandoned water well
 2 Sewer lines 5 Cess pool 8 Sewage lagoon 11 Fuel storage 15 Oil well/Gas well
 3 Watertight sewer lines 6 Seepage pit 9 Feedyard 12 Fertilizer storage 16 Other (specify below)
 13 Insecticide storage

Direction from well? S E How many feet? 150

FROM	TO	LITHOLOGIC LOG	FROM	TO	PLUGGING INTERVALS
Top	4	top soil			
4	30	Blue shale			
30	33	Blue Racking shale			
33	50	Blue shale			
50	54	gravel Blue shale			
54	61	Blue shale			

7 CONTRACTOR'S OR LANDOWNER'S CERTIFICATION: This water well was constructed, (2) reconstructed, or (3) plugged under my jurisdiction and was completed on (mo/day/year) May 14, 1990 and this record is true to the best of my knowledge and belief. Kansas Water Well Contractor's License No. 221 This Water Well Record was completed on (mo/day/yr) May 15 under the business name of Teran Budd by (signature) Teran Budd